

AMENDMENTS:		
AMENDMENT	DATE	DESCRIPTION
R1	10.12.21	NO CHANGE THIS SHEET

- NOTES:
- This plan has been prepared for sewer asbuilt purposes only. No liability is accepted if the plan is used for any other purpose.
 - Any measurements taken from information which is not dimensioned on the electronic copy are at the risk of the recipient.
 - All sewer pipes are 150mm Ø uPVC SN16 unless shown otherwise specified.
 - All sewer laterals are 100mm Ø uPVC SN16 unless otherwise specified.
 - All asbuilt information has been provided by BG Contracting Ltd and has not been verified. No liability is accepted in relation to their locations.
 - All roading and footpath information is design.
 - Origin of Levels:**
Levels are in terms of Mean Sea Level (Lyttelton Vertical Datum 1937) prior to Canterbury earthquakes of 2010 and 2011.

LEGEND

LL =	LID LEVEL
IL =	INVERT LEVEL
SANITARY SEWER	
EXISTING SANITARY SEWER	
DESIGN KERB	
DESIGN FOOTPATH	

DAVIE LOVELL-SMITH
PLANNING SURVEYING ENGINEERING

116 Wrights Road P O Box 679 Christchurch 8140. New Zealand
Telephone: 03 379-0793 Website: www.dls.co.nz E-mail: office@dls.co.nz

JOB TITLE:
**South West Faringdon
Stage 1
RC 215485 & RC 215810**


SHEET TITLE:
Sewer Asbuilt

DRAWING STATUS:
Asbuilt

SCALE: 1:500@A1 DATE: December 2021
1:1000@A3

CAD FILE: J:\2025\ASBUILTS\STAGE 1\H2025\STG 1 AB_NZTM R1.dwg DRAWN: CR


DRAWING No: E.20256.AB.SS01 SHEET No: R1 REVISION:

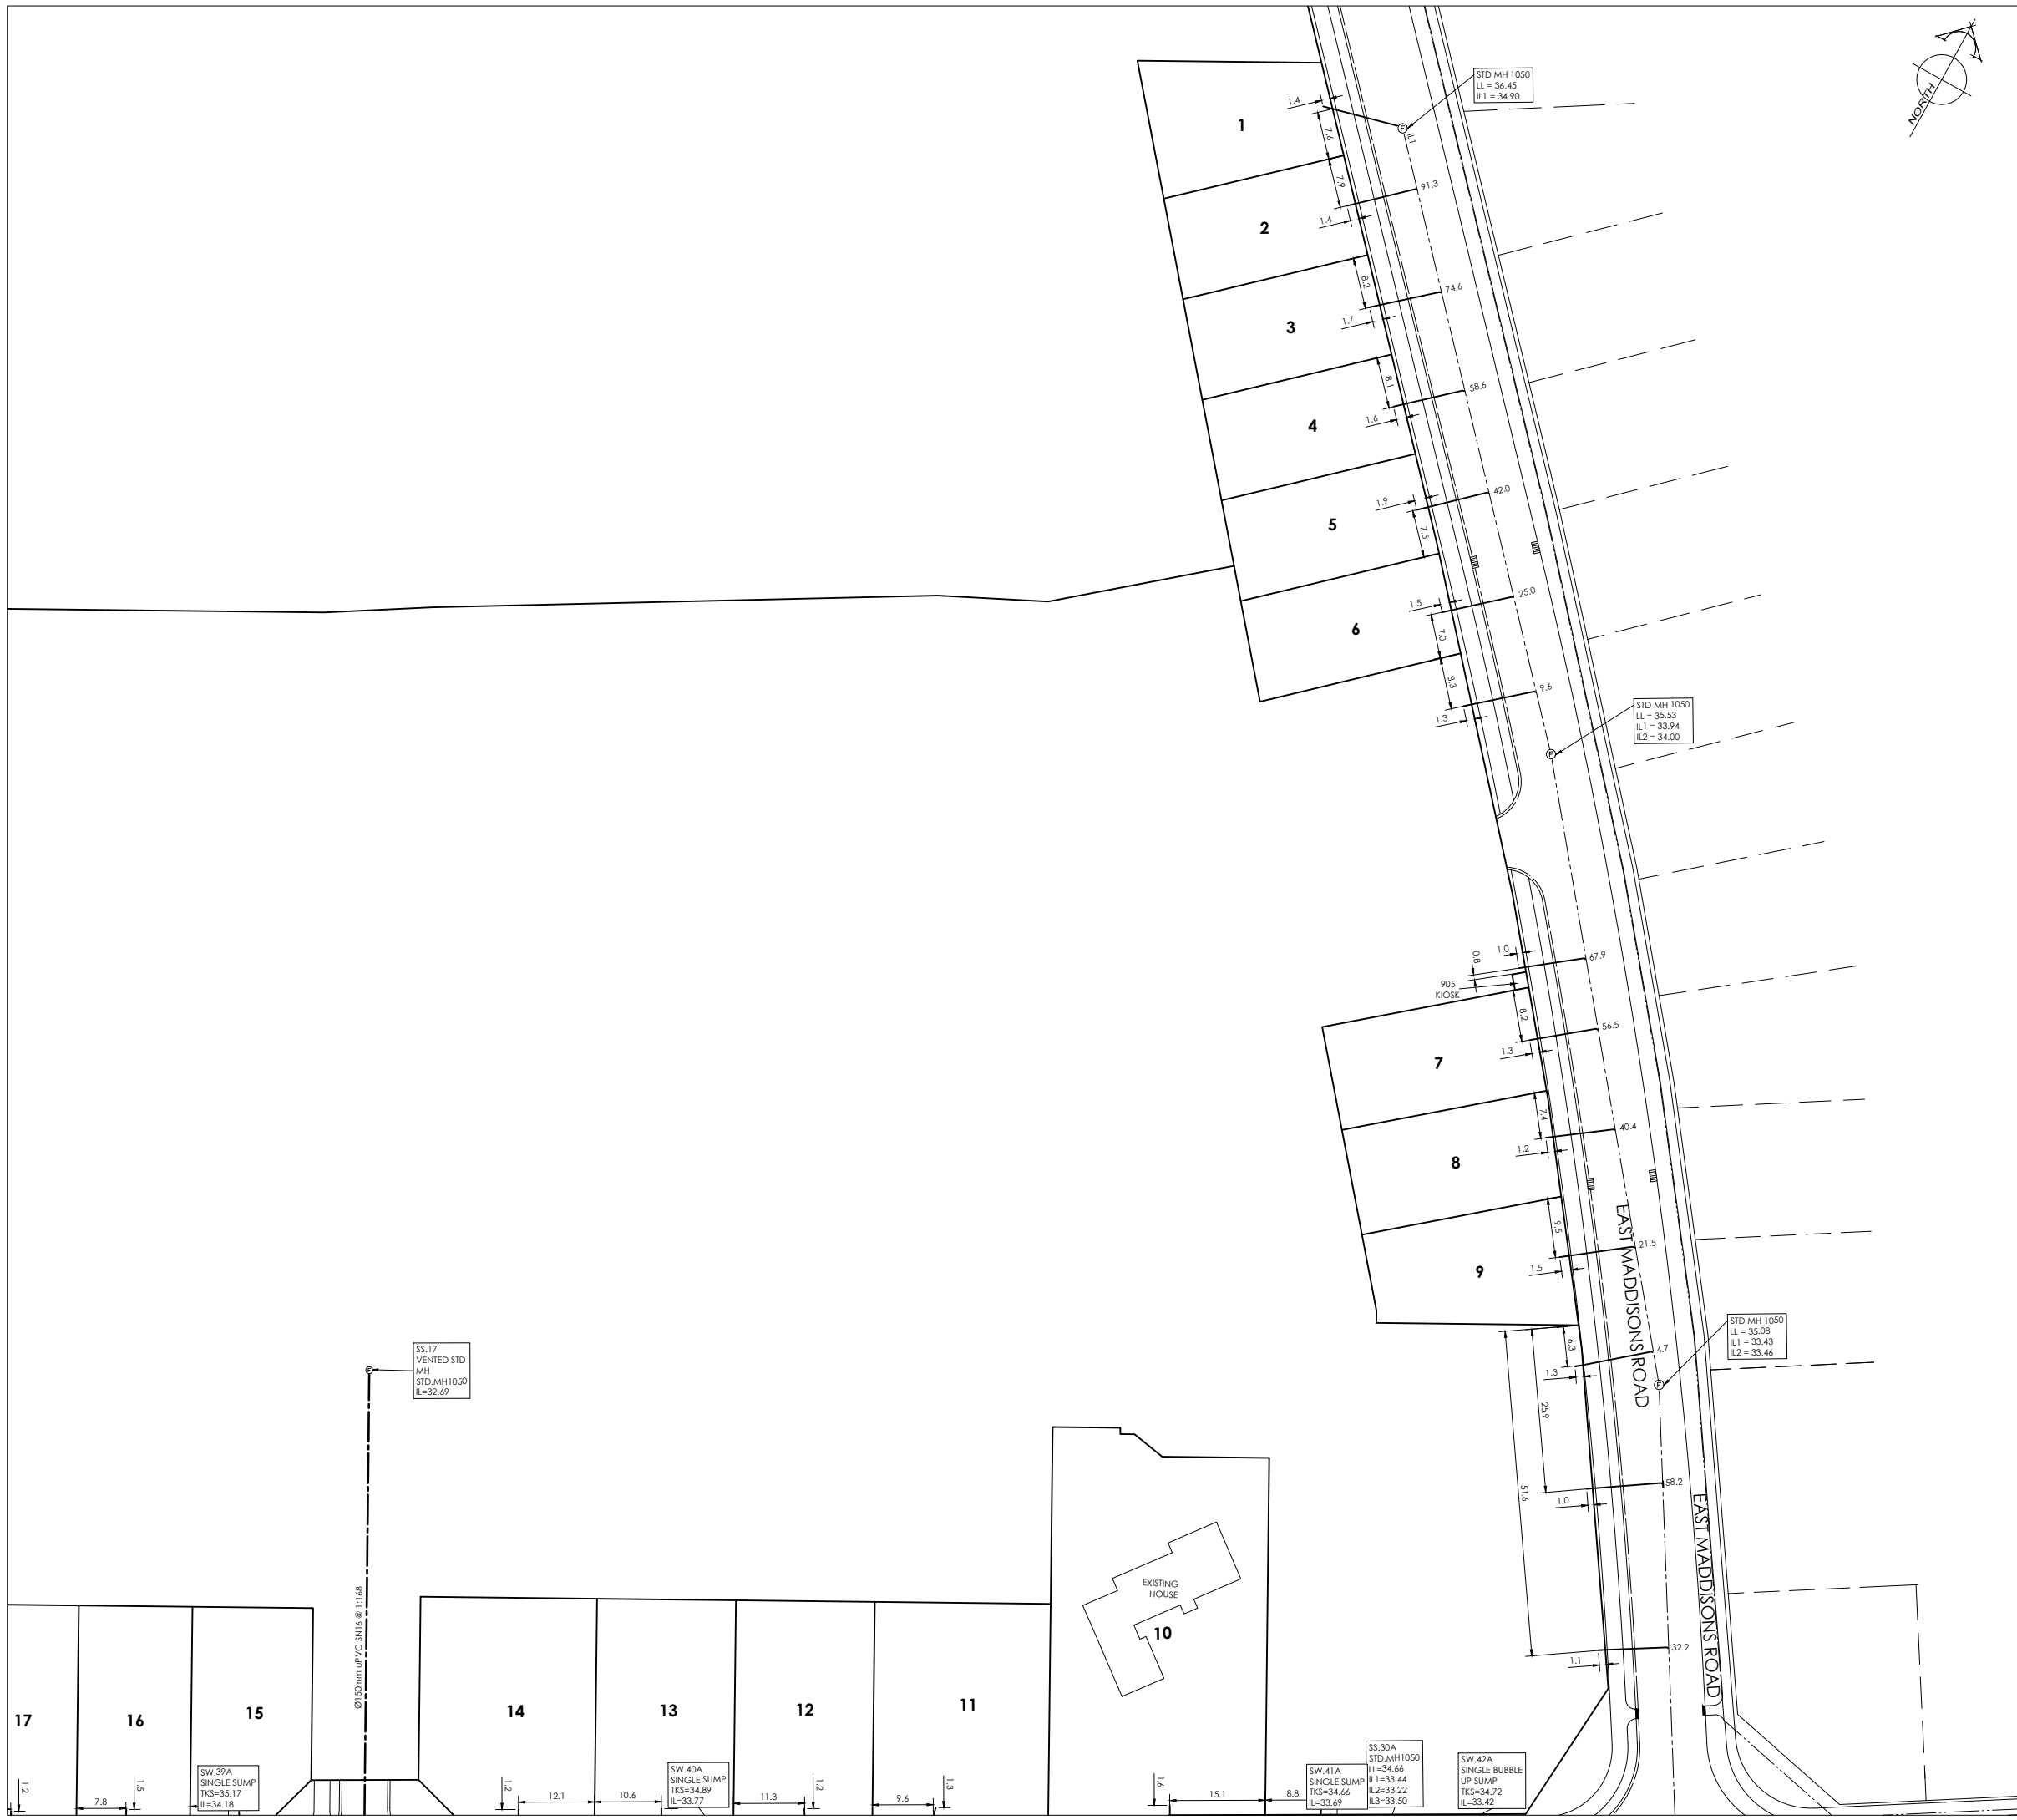

AMENDMENTS:		
AMENDMENT	DATE	DESCRIPTION
R1	10.12.21	NO CHANGE THIS SHEET

- NOTES:
1. This plan has been prepared for sewer asbuilt purposes only. No liability is accepted if the plan is used for any other purpose.
 2. Any measurements taken from information which is not dimensioned on the electronic copy are at the risk of the recipient.
 3. All sewer pipes are 150mmØ uPVC SNI16 unless shown otherwise specified.
 4. All sewer laterals are 100mmØ uPVC SNI16 unless otherwise specified.
 5. All asbuilt information has been provided by BG Contracting Ltd and have not been verified. No liability is accepted in relation to their locations.
 6. All roading and footpath information is design.
 7. **Origin of Levels:**
Levels are in terms of Mean Sea Level (Lyttelton Vertical Datum 1937) prior to Canterbury earthquakes of 2010 and 2011.

LEGEND

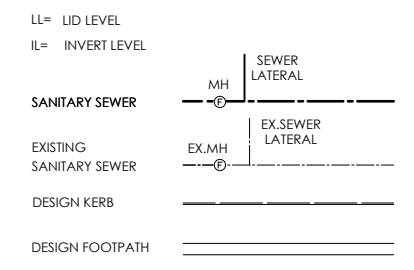

116 Wrights Road P O Box 679 Christchurch 8140. New Zealand
 Telephone: 03 379-0793 Website: www.dls.co.nz E-mail: office@dls.co.nz

JOB TITLE:
**South West Faringdon
 Stage 1
 RC 215485 & RC 215810**





SHEET TITLE:
Sewer Asbuilt

DRAWING STATUS:
Asbuilt

SCALE: 1:500@A1
 1:1000@A3
 DATE: December 2021


CAD FILE: J:\2025\ASBUILT\STAGE 1\H20256_STG 1 AB_NZIM R1.dwg
 DRAWN: CR

DRAWING No: **E.20256.AB.SS02**
 SHEET No: **R1**
 REVISION:

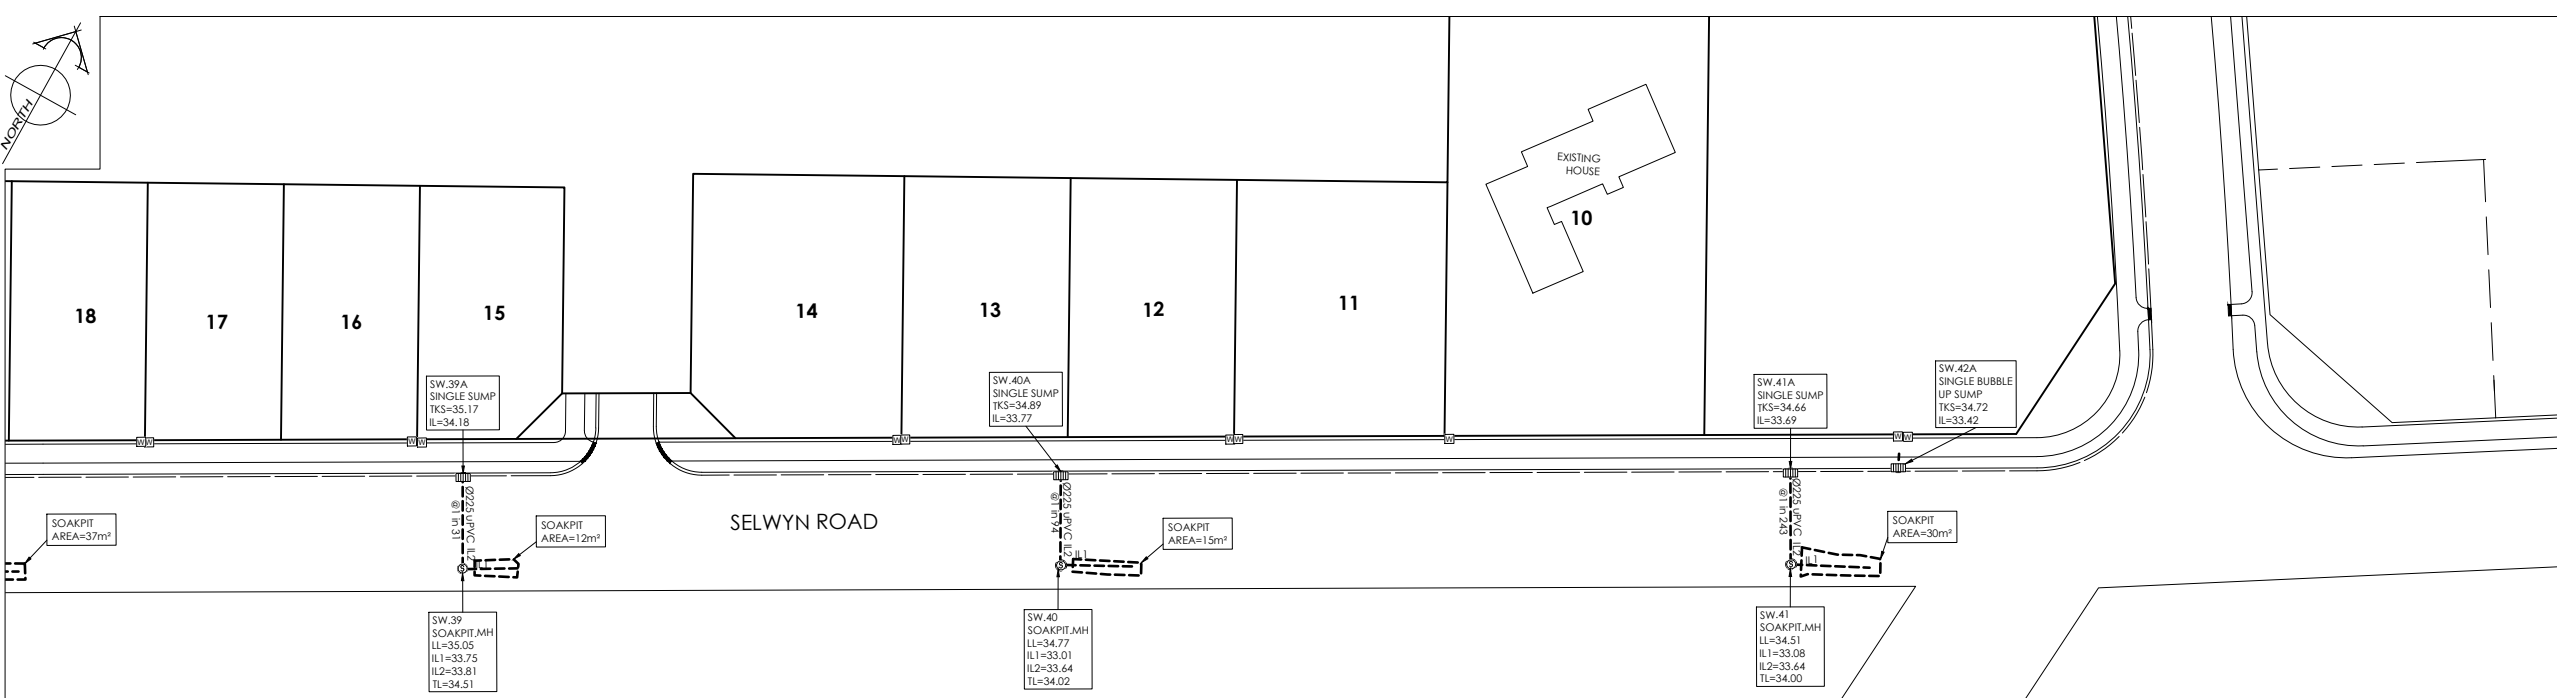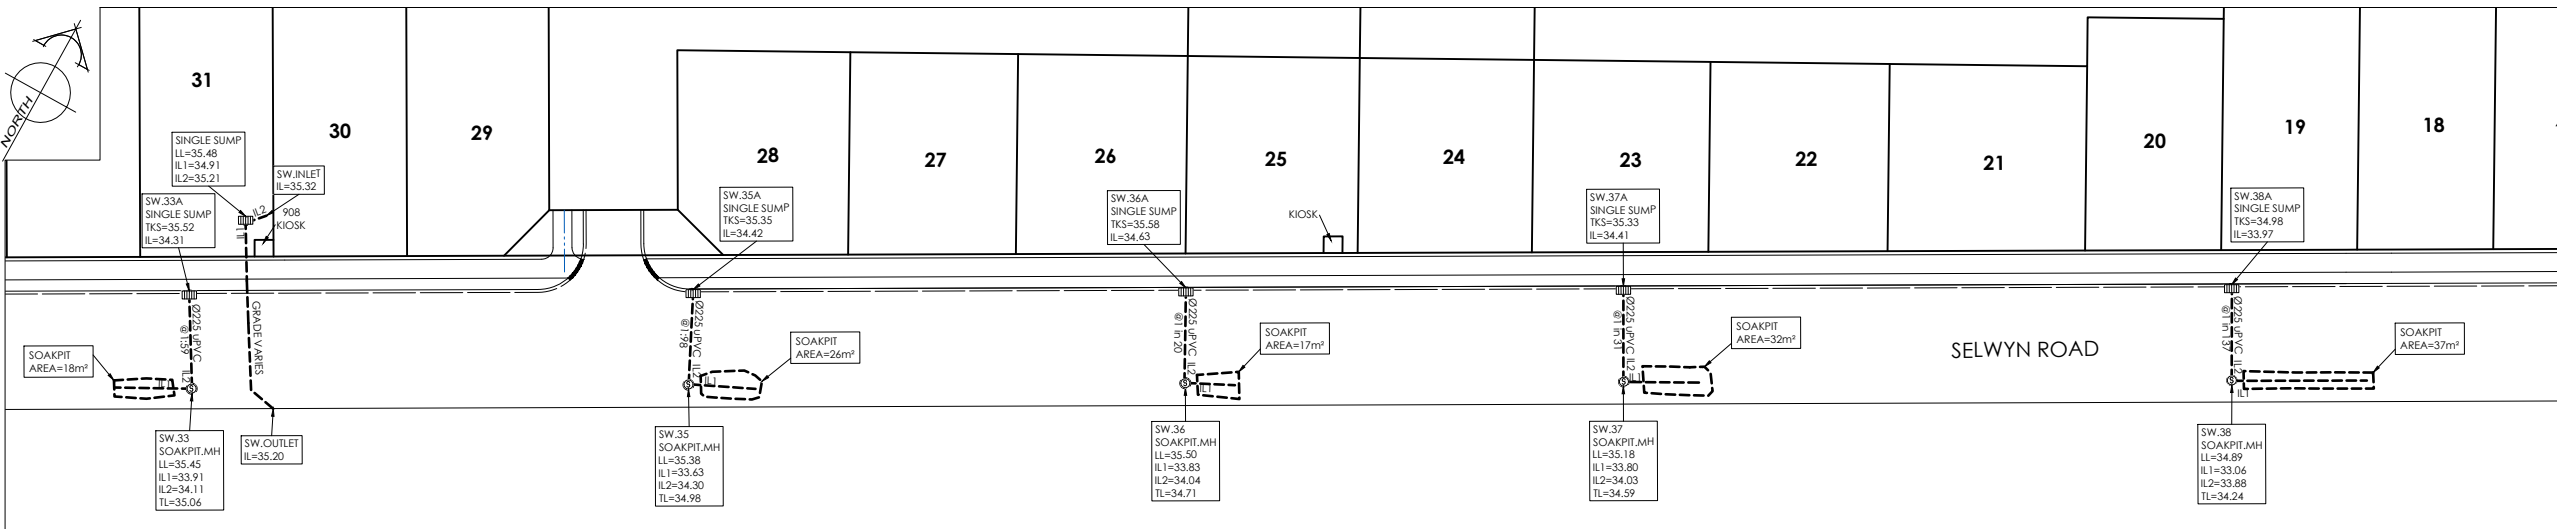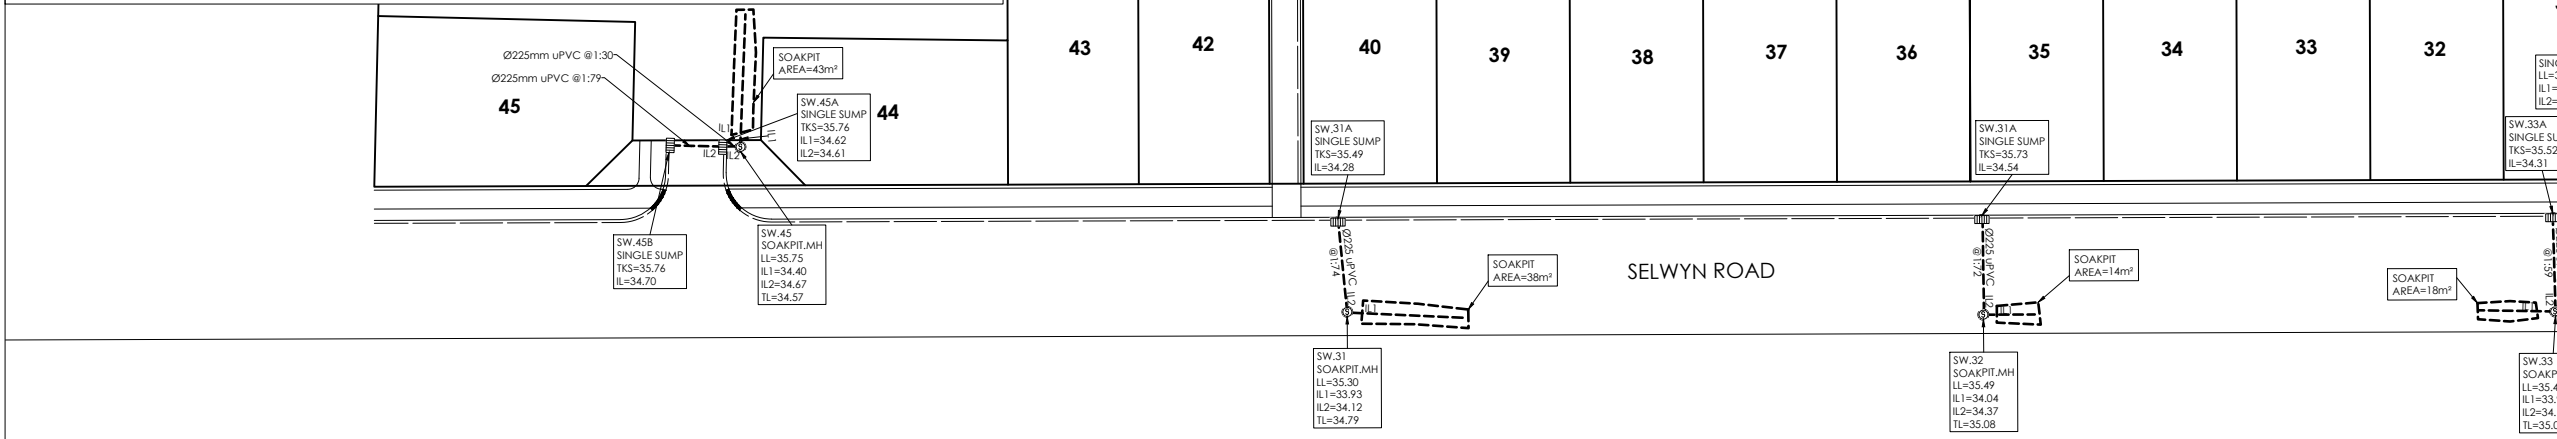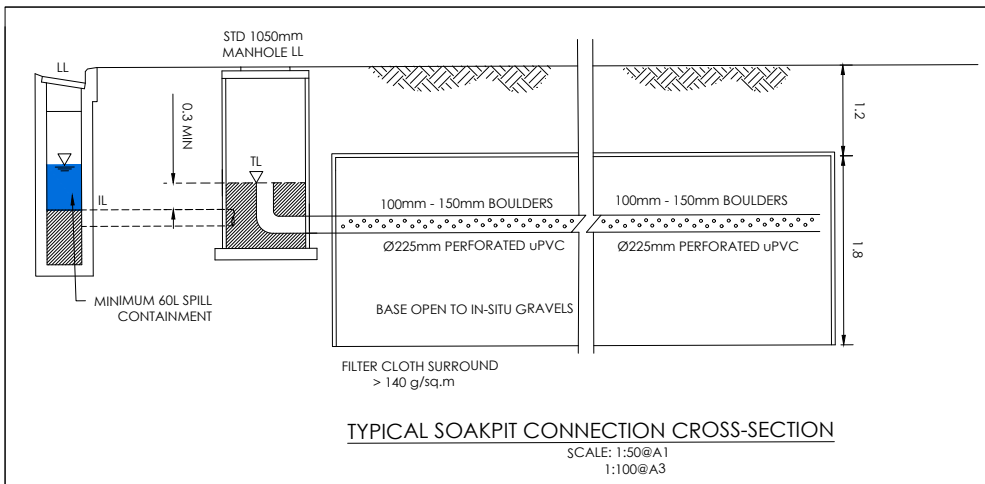

AMENDMENTS:		
AMENDMENT	DATE	DESCRIPTION
R1	10.12.21	NO CHANGE THIS SHEET

- NOTES:
- This plan has been prepared for stormwater asbuilt purposes only. No liability is accepted if the plan is used for any other purpose.
 - Any measurements taken from information which is not dimensioned on the electronic copy are at the risk of the recipient.
 - All stormwater pipes are 225mmØ uPVC SN16 unless shown otherwise specified.
 - All asbuilt information has been provided by BG Contracting Ltd and have not been verified. No liability is accepted in relation to their locations.
 - All roading and footpath information is design.
 - Origin of Levels: Levels are in terms of Mean Sea Level (Lytelton Vertical Datum 1937) prior to Canterbury earthquakes of 2010 and 2011.

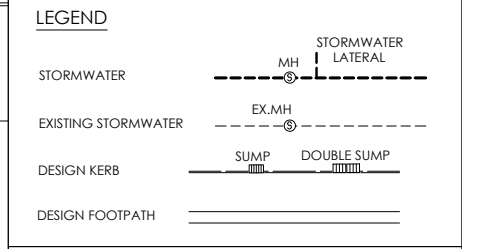

DAVIE LOVELL-SMITH
PLANNING SURVEYING ENGINEERING

116 Wrights Road P O Box 679 Christchurch 8140. New Zealand
Telephone: 03 379-0793 Website: www.dls.co.nz E-mail: office@dls.co.nz

JOB TITLE:
South West Faringdon Stage 1 RC 215485 & RC 215810

SHEET TITLE:
Stormwater Asbuilt

DRAWING STATUS:
Asbuilt

SCALE: 1:500@A1 DATE: December 2021
1:1000@A3


CAD FILE: J:\2025\ASBUILT\STAGE 1\H2025\STG 1 AB_NZTM R1.dwg DRAWN: CR

DRAWING No: **E.20256.AB.SW01** SHEET No: **R1** REVISION:



AMENDMENTS:		
AMENDMENT	DATE	DESCRIPTION
R1	10.12.21	WATER METER SERIAL NUMBERS ADDED

- NOTES:
1. This plan has been prepared for water asbuilt purposes only. No liability is accepted if the plan is used for any other purpose.
 2. Any measurements taken from information which is not dimensioned on the electronic copy are at the risk of the recipient.
 3. The asbuilt locations of all water mains, fire hydrants and valves have been provided by BG Contracting Ltd. No liability is accepted in relation to their accuracy or their location.
 4. All house connections are 25mm poly and include gate valve, toby box, tapping band and ferrule.
 5. All water laterals are Ø25mm PE BlueLine PN12.5 with associated fittings unless otherwise specified.
 6. All roading and footpath information is asbuilt.
 7. All water mains are uPVC Ø200mm PN12.

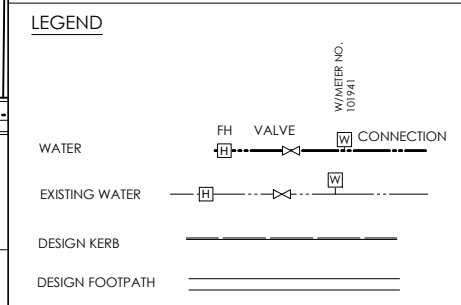

116 Wrights Road P O Box 679 Christchurch 8140. New Zealand
 Telephone: 03 379-0793 Website: www.dls.co.nz E-mail: office@dls.co.nz


JOB TITLE:
**South West Faringdon
 Stage 1
 RC 215485 & RC 215810**

SHEET TITLE:
Water Asbuilt

DRAWING STATUS:
Asbuilt


SCALE: 1:500@A1 DATE: December 2021
 1:1000@A3

CAD FILE: J:\2025\ASBUILT\STAGE 1\2025\STG 1 AB_NZTM R1.dwg DRAWN: CR
 DRAWING No: SHEET No: REVISION:
E.20256.AB.WS01 R1

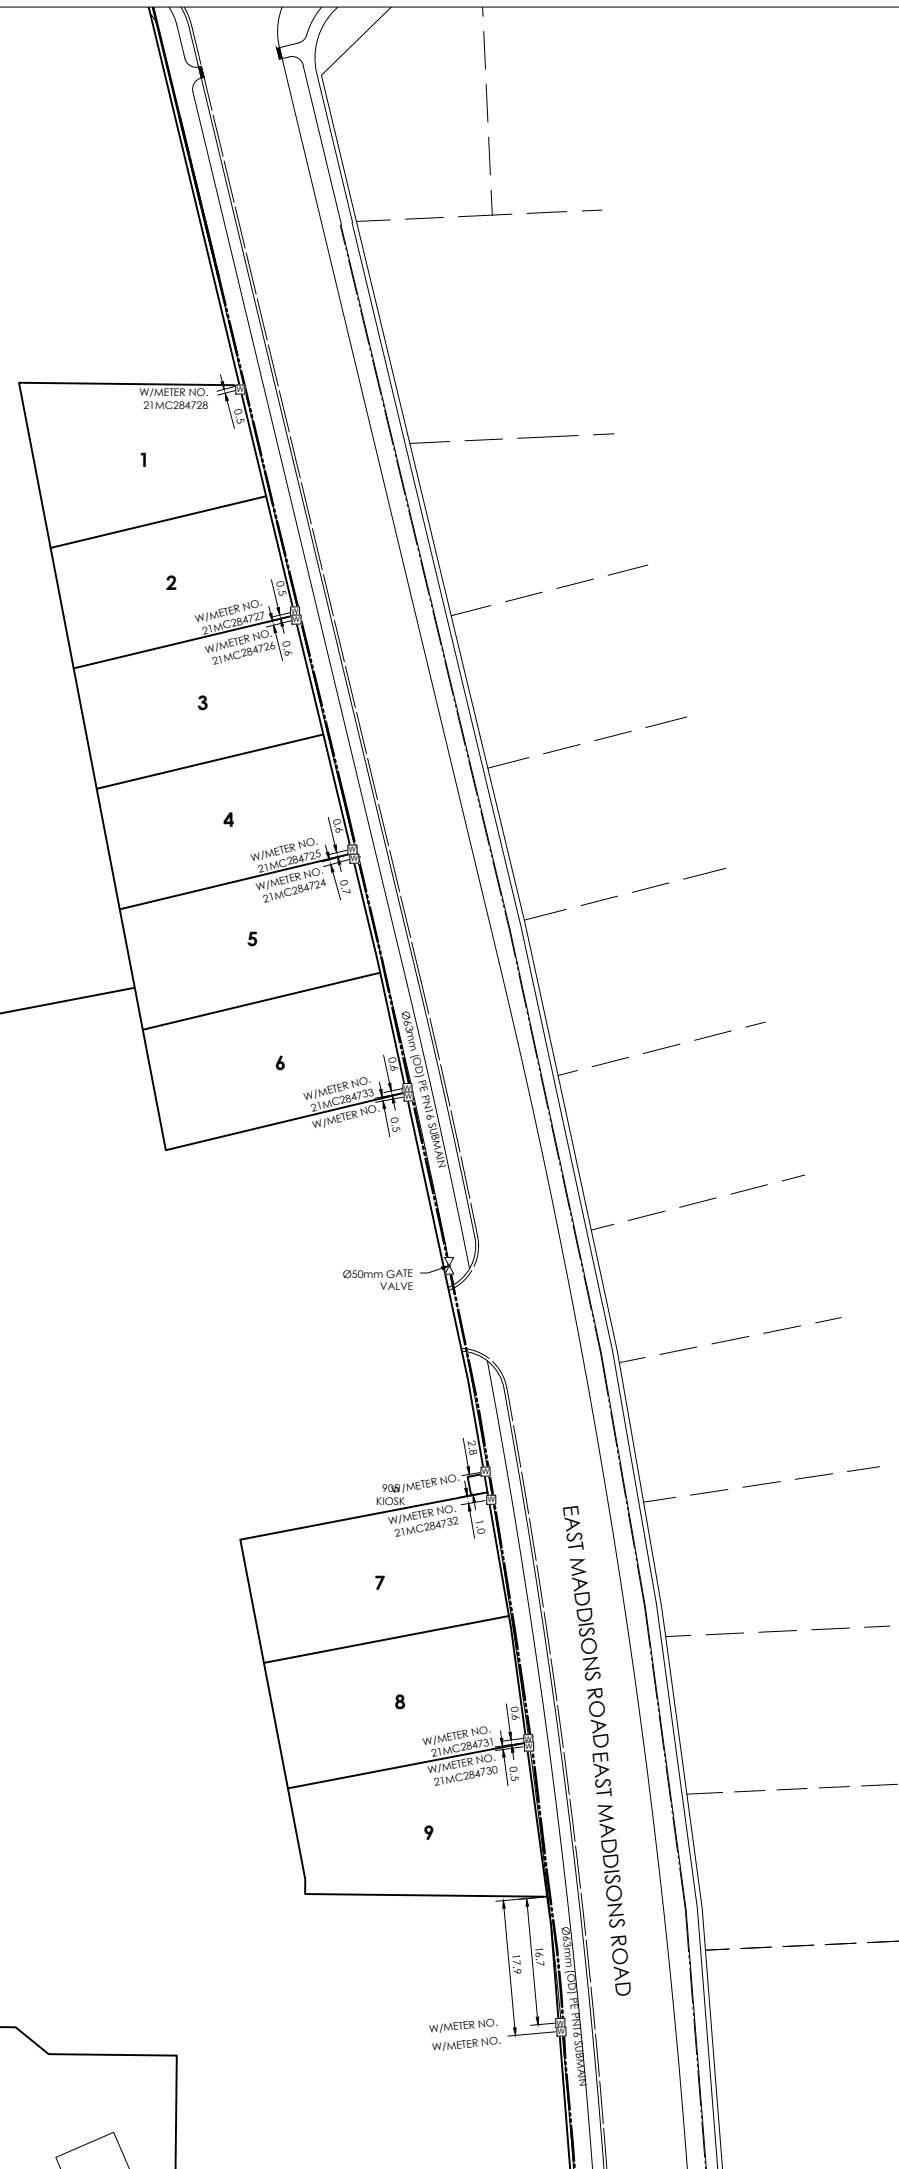

AMENDMENTS:		
AMENDMENT	DATE	DESCRIPTION
R1	10.12.21	WATER METER SERIAL NUMBERS ADDED

- NOTES:
1. This plan has been prepared for water asbuilt purposes only. No liability is accepted if the plan is used for any other purpose.
 2. Any measurements taken from information which is not dimensioned on the electronic copy are at the risk of the recipient.
 3. The asbuilt locations of all watermains, fire hydrants and valves have been provided by BG Contracting Ltd. No liability is accepted in relation to their accuracy or their location.
 4. All house connections are 25mm poly and include gate valve, toby box, tapping band and ferrule.
 5. All water laterals are Ø25mm PE BlueLine PN12.5 with associated fittings unless otherwise specified.
 6. All roading and footpath information is asbuilt.
 7. All watermains are uPVC Ø200mm PN12.

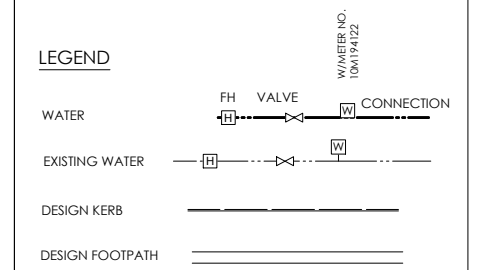

116 Wrights Road P O Box 679 Christchurch 8140. New Zealand
 Telephone: 03 379-0793 Website: www.dls.co.nz E-mail: office@dls.co.nz

JOB TITLE:
**South West Faringdon
 Stage 1
 RC 215485 & RC 215810**

SHEET TITLE:
Water Asbuilt

DRAWING STATUS:
Asbuilt

SCALE: 1:500@A1 DATE: December 2021
 1:1000@A3

CAD FILE: J:\2025\ASBUILT\STAGE 1\H20256_STG 1 AB_NZIM R1.dwg DRAWN: CR
 DRAWING No: SHEET No: REVISION:
E.20256.AB.WS02 R1