

AMENDMENTS:		
AMENDMENT	DATE	DESCRIPTION

NOTES:

- This plan has been prepared for sewer asbuilt purposes only. No liability is accepted if the plan is used for any other purpose.
- Any measurements taken from information which is not dimensioned on the electronic copy are at the risk of the recipient.
- All sewer pipes are 150mmØ uPVC SN16 unless shown otherwise specified.
- All sewer laterals are 100mmØ uPVC SN16 unless otherwise specified.
- All asbuilt information has been provided by BG Contracting Ltd and has not been verified. No liability is accepted in relation to their locations.
- All roading and footpath information is asbuilt.
- Origin of Levels:
Levels are in terms of Mean Sea Level (Lyttelton Vertical Datum 1937) prior to Canterbury earthquakes of 2010 and 2011.

LEGEND

LL= LID LEVEL
IL= INVERT LEVEL


SANITARY SEWER: MH (circle with cross), EX.MH (circle with cross)

EXISTING SANITARY SEWER: Dashed line with cross

ASBUILT KERB AND CHANNEL: Solid line with cross

ASBUILT FOOTPATH: Solid line

CUTDOWN: Dashed line


DAVIE LOVELL-SMITH
 PLANNING SURVEYING ENGINEERING

116 Wrights Road P O Box 679 Christchurch 8140. New Zealand
 Telephone: 03 379-0793 Website: www.dls.co.nz E-mail: office@dls.co.nz

JOB TITLE:
**South West Faringdon
 Stage 4
 RC 215485 & RC 215965**

SHEET TITLE:
Sewer Asbuilt

DRAWING STATUS:
Asbuilt

SCALE: 1:500@A1 DATE: July 2022
 1:1000@A3

CAD FILE: J:\2025\ASBUILT\STAGE 4\H20256_STG 4 AB_NZTM_R0.dwg DRAWN: CR
 DRAWING No: SHEET No: REVISION:
H.20534.AB.SS01 RO



AMENDMENTS :		
AMENDMENT	DATE	DESCRIPTION

- NOTES :
1. This plan has been prepared for sewer asbuilt purposes only. No liability is accepted if the plan is used for any other purpose.
 2. Any measurements taken from information which is not dimensioned on the electronic copy are at the risk of the recipient.
 3. All sewer pipes are 150mmØ uPVC SN16 unless shown otherwise specified.
 4. All sewer laterals are 100mmØ uPVC SN16 unless otherwise specified.
 5. All asbuilt information has been provided by BG Contracting Ltd and has not been verified. No liability is accepted in relation to their locations.
 6. All roading and footpath information is asbuilt.
 7. Origin of Levels:
Levels are in terms of Mean Sea Level (Lyttelton Vertical Datum 1937) prior to Canterbury earthquakes of 2010 and 2011.

LEGEND

LL=	LID LEVEL
IL=	INVERT LEVEL
SANITARY SEWER	SEWER LATERAL
EXISTING SANITARY SEWER	EX. SEWER LATERAL
ASBUILT KERB AND CHANNEL	CUTDOWN
ASBUILT FOOTPATH	CUTDOWN


DAVIE LOVELL-SMITH
 PLANNING SURVEYING ENGINEERING

116 Wrights Road P O Box 679 Christchurch 8140. New Zealand
 Telephone: 03 379-0793 Website: www.dls.co.nz E-mail: office@dls.co.nz

JOB TITLE:
**South West Faringdon
 Stage 4
 RC 215485 & RC 215965**


SHEET TITLE:
Sewer Asbuilt

DRAWING STATUS:
Asbuilt

SCALE: 1:500@A1 DATE: July 2022
 1:1000@A3

CAD FILE: J:\2025\ASBUILT\STAGE 4\H2025\STG 4 AB_NZTM_R0.dwg DRAWN: CR
 DRAWING No: SHEET No: REVISION:
H.20534.AB.SS02 RO

SELWYN ROAD

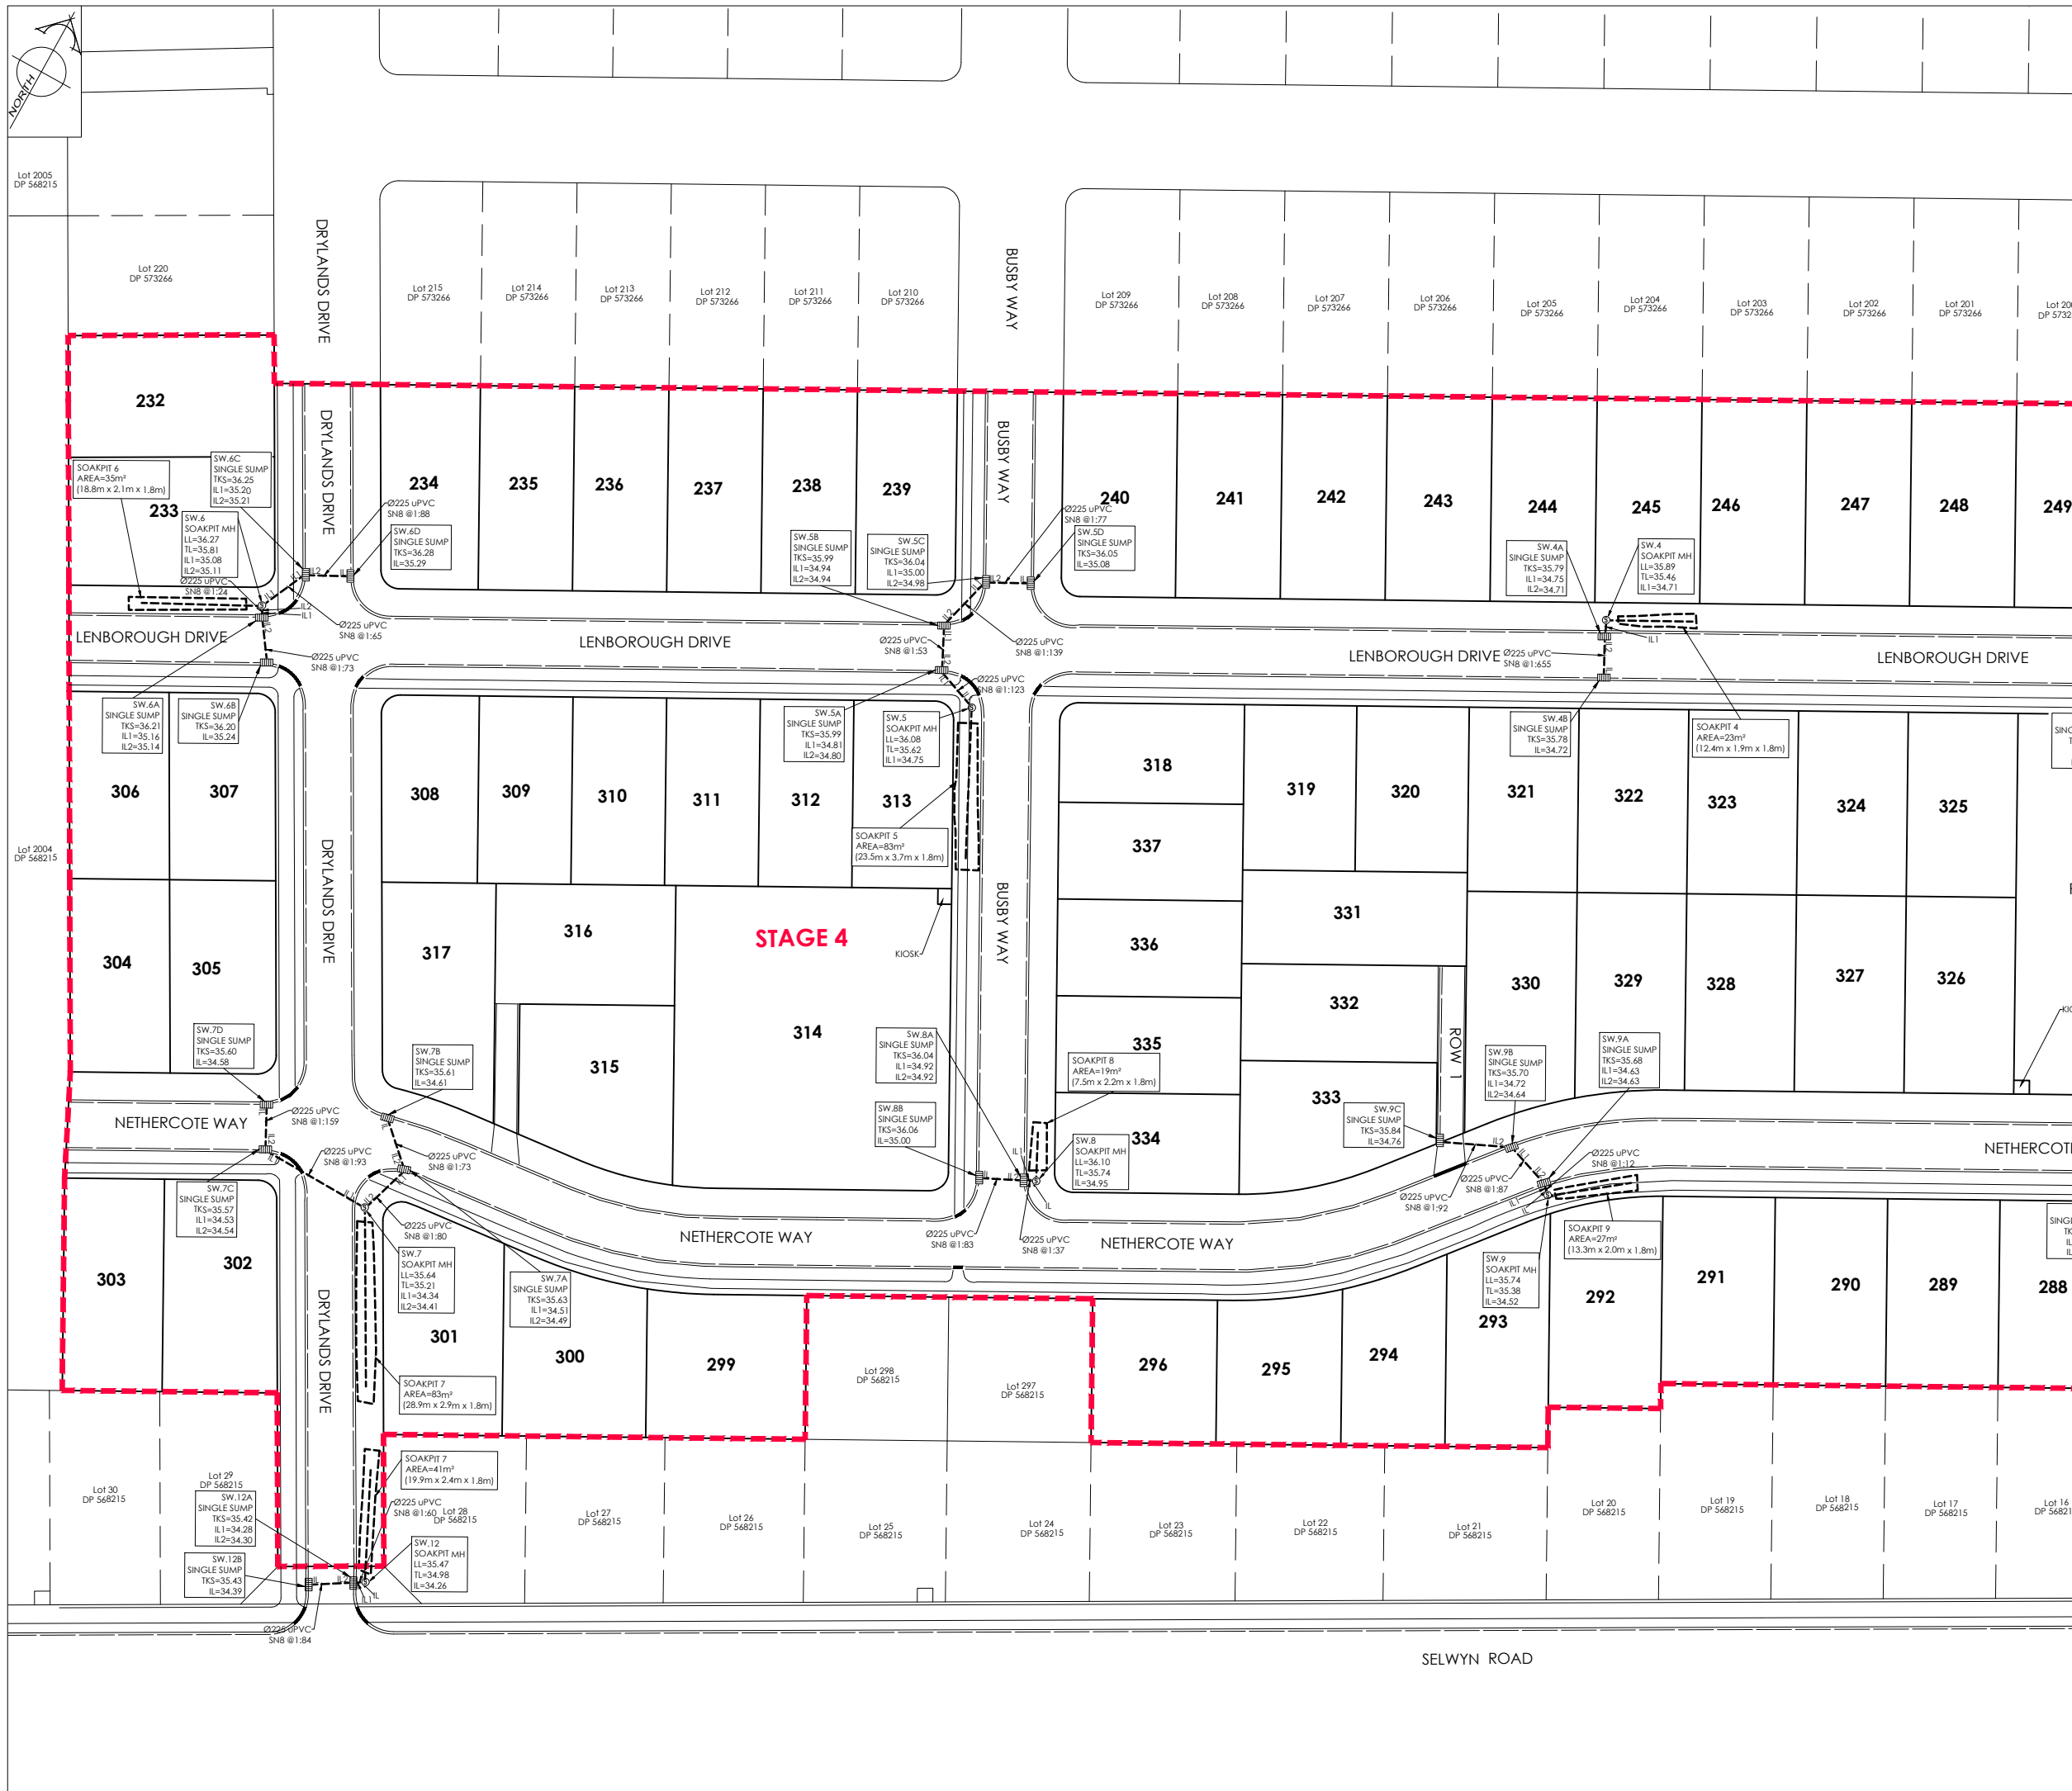

AMENDMENTS:		
AMENDMENT	DATE	DESCRIPTION

- NOTES:
1. This plan has been prepared for stormwater asbuilt purposes only. No liability is accepted if the plan is used for any other purpose.
 2. Any measurements taken from information which is not dimensioned on the electronic copy are at the risk of the recipient.
 3. All stormwater pipes are 225mmØ uPVC SN16 unless shown otherwise specified.
 4. All asbuilt information has been provided by BG Contracting Ltd and have not been verified. No liability is accepted in relation to their locations.
 5. All roading and footpath information is asbuilt.
 6. Origin of Levels:
Levels are in terms of Mean Sea Level (Lyttelton Vertical Datum 1937) prior to Canterbury earthquakes of 2010 and 2011.

LEGEND

STORMWATER	
EXISTING STORMWATER	
ASBUILT KERB AND CHANNEL	
ASBUILT FOOTPATH	

DAVE LOVELL-SMITH
PLANNING SURVEYING ENGINEERING


116 Wrights Road P O Box 679 Christchurch 8140. New Zealand
Telephone: 03 379-0793 Website: www.dls.co.nz E-mail: office@dls.co.nz

JOB TITLE:
**South West Faringdon
Stage 4
RC 215485 & RC 215965**

SHEET TITLE:
Stormwater Asbuilt

DRAWING STATUS:
Asbuilt

SCALE: 1:500@A1 1:1000@A3	DATE: July 2022
CAD FILE: J:\2025\ASBUILT\STAGE 4\H20256_STG 4 AB_NZTM_R0.dwg	DRAWN: CR
DRAWING No: H.20534.AB.SW01	REVISION: RO

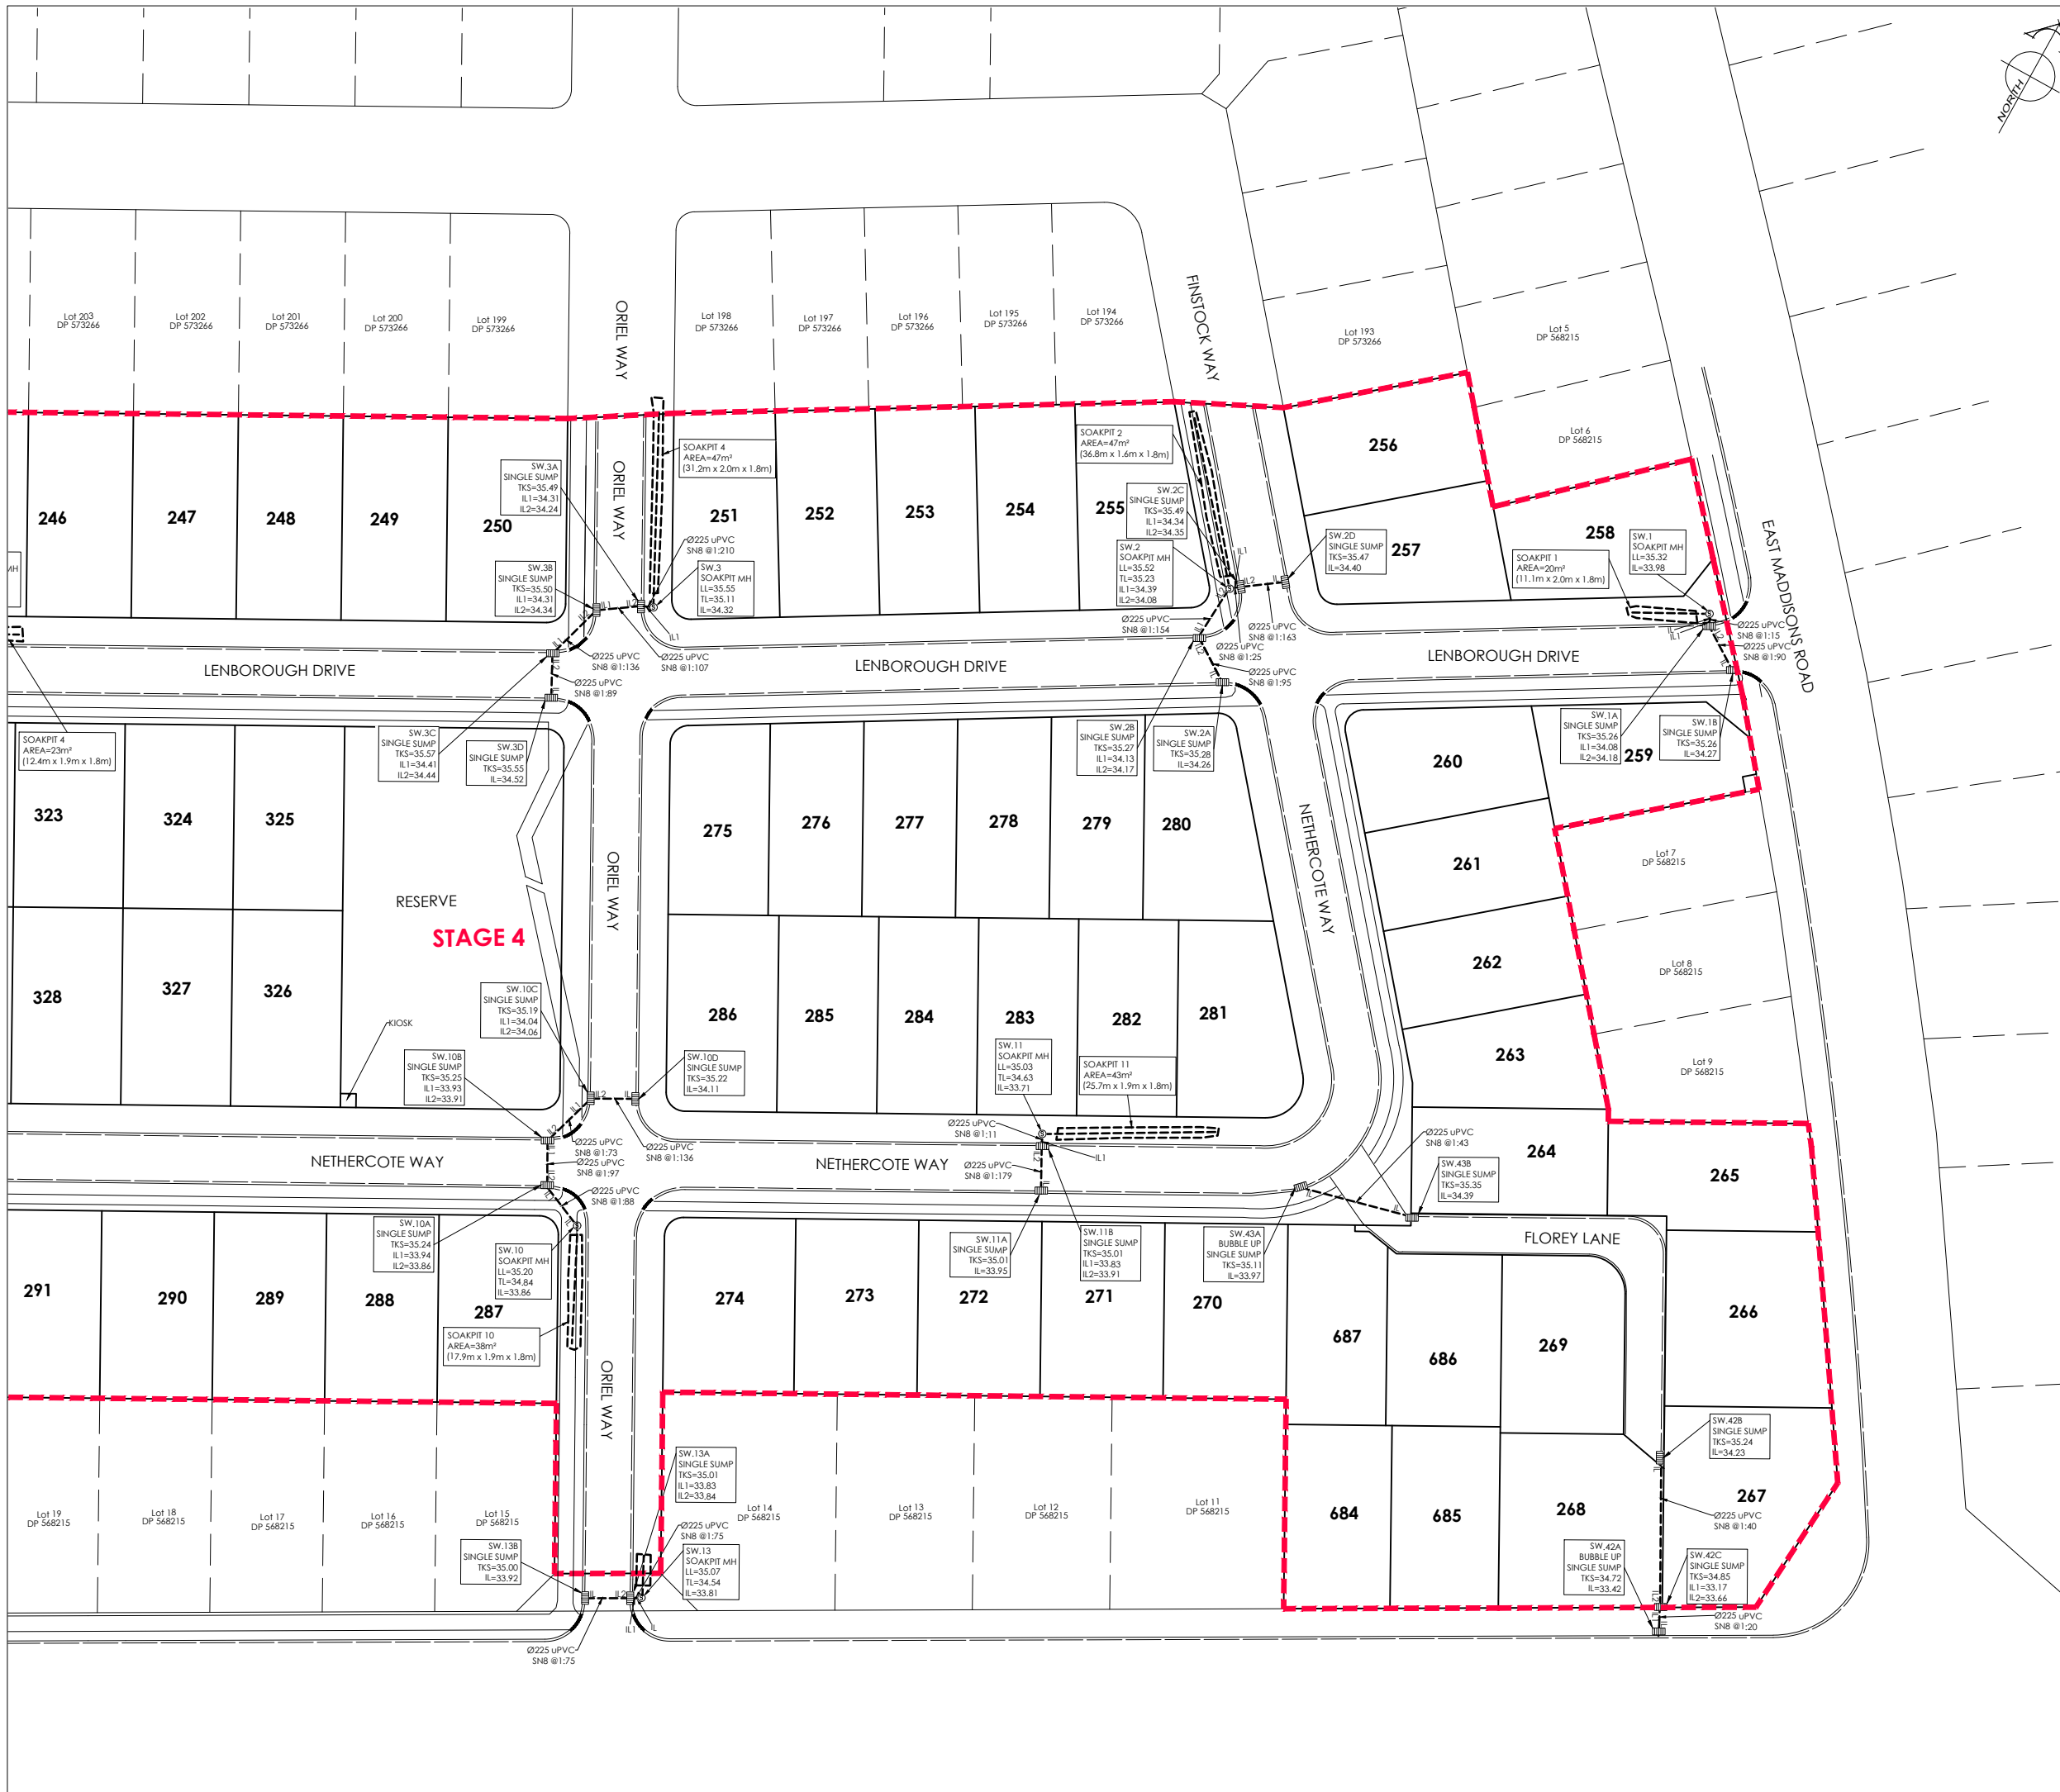

AMENDMENTS:		
AMENDMENT	DATE	DESCRIPTION

- NOTES:
1. This plan has been prepared for stormwater asbuilt purposes only. No liability is accepted if the plan is used for any other purpose.
 2. Any measurements taken from information which is not dimensioned on the electronic copy are at the risk of the recipient.
 3. All stormwater pipes are 225mmØ uPVC SN16 unless shown otherwise specified.
 4. All asbuilt information has been provided by BG Contracting Ltd and have not been verified. No liability is accepted in relation to their locations.
 5. All roading and footpath information is asbuilt.
 6. Origin of Levels:
Levels are in terms of Mean Sea Level (Lyttelton Vertical Datum 1937) prior to Canterbury earthquakes of 2010 and 2011.

LEGEND

STORMWATER	
EXISTING STORMWATER	
ASBUILT KERB AND CHANNEL	
ASBUILT FOOTPATH	


DAVIE LOVELL-SMITH
 PLANNING SURVEYING ENGINEERING

116 Wrights Road P O Box 679 Christchurch 8140. New Zealand
 Telephone: 03 379-0793 Website: www.dls.co.nz E-mail: office@dls.co.nz


JOB TITLE:
**South West Faringdon
 Stage 4
 RC 215485 & RC215965**

SHEET TITLE:
Stormwater Asbuilt

DRAWING STATUS:
Asbuilt


SCALE: 1:500@A1 DATE: July 2022
 1:1000@A3

CAD FILE: J:\2025\ASBUILT\STAGE 4\H2025\STG 4 AB_NZTM_R0.dwg DRAWN: CR
 DRAWING No: SHEET No: REVISION:
H.20534.AB.SW02 RO

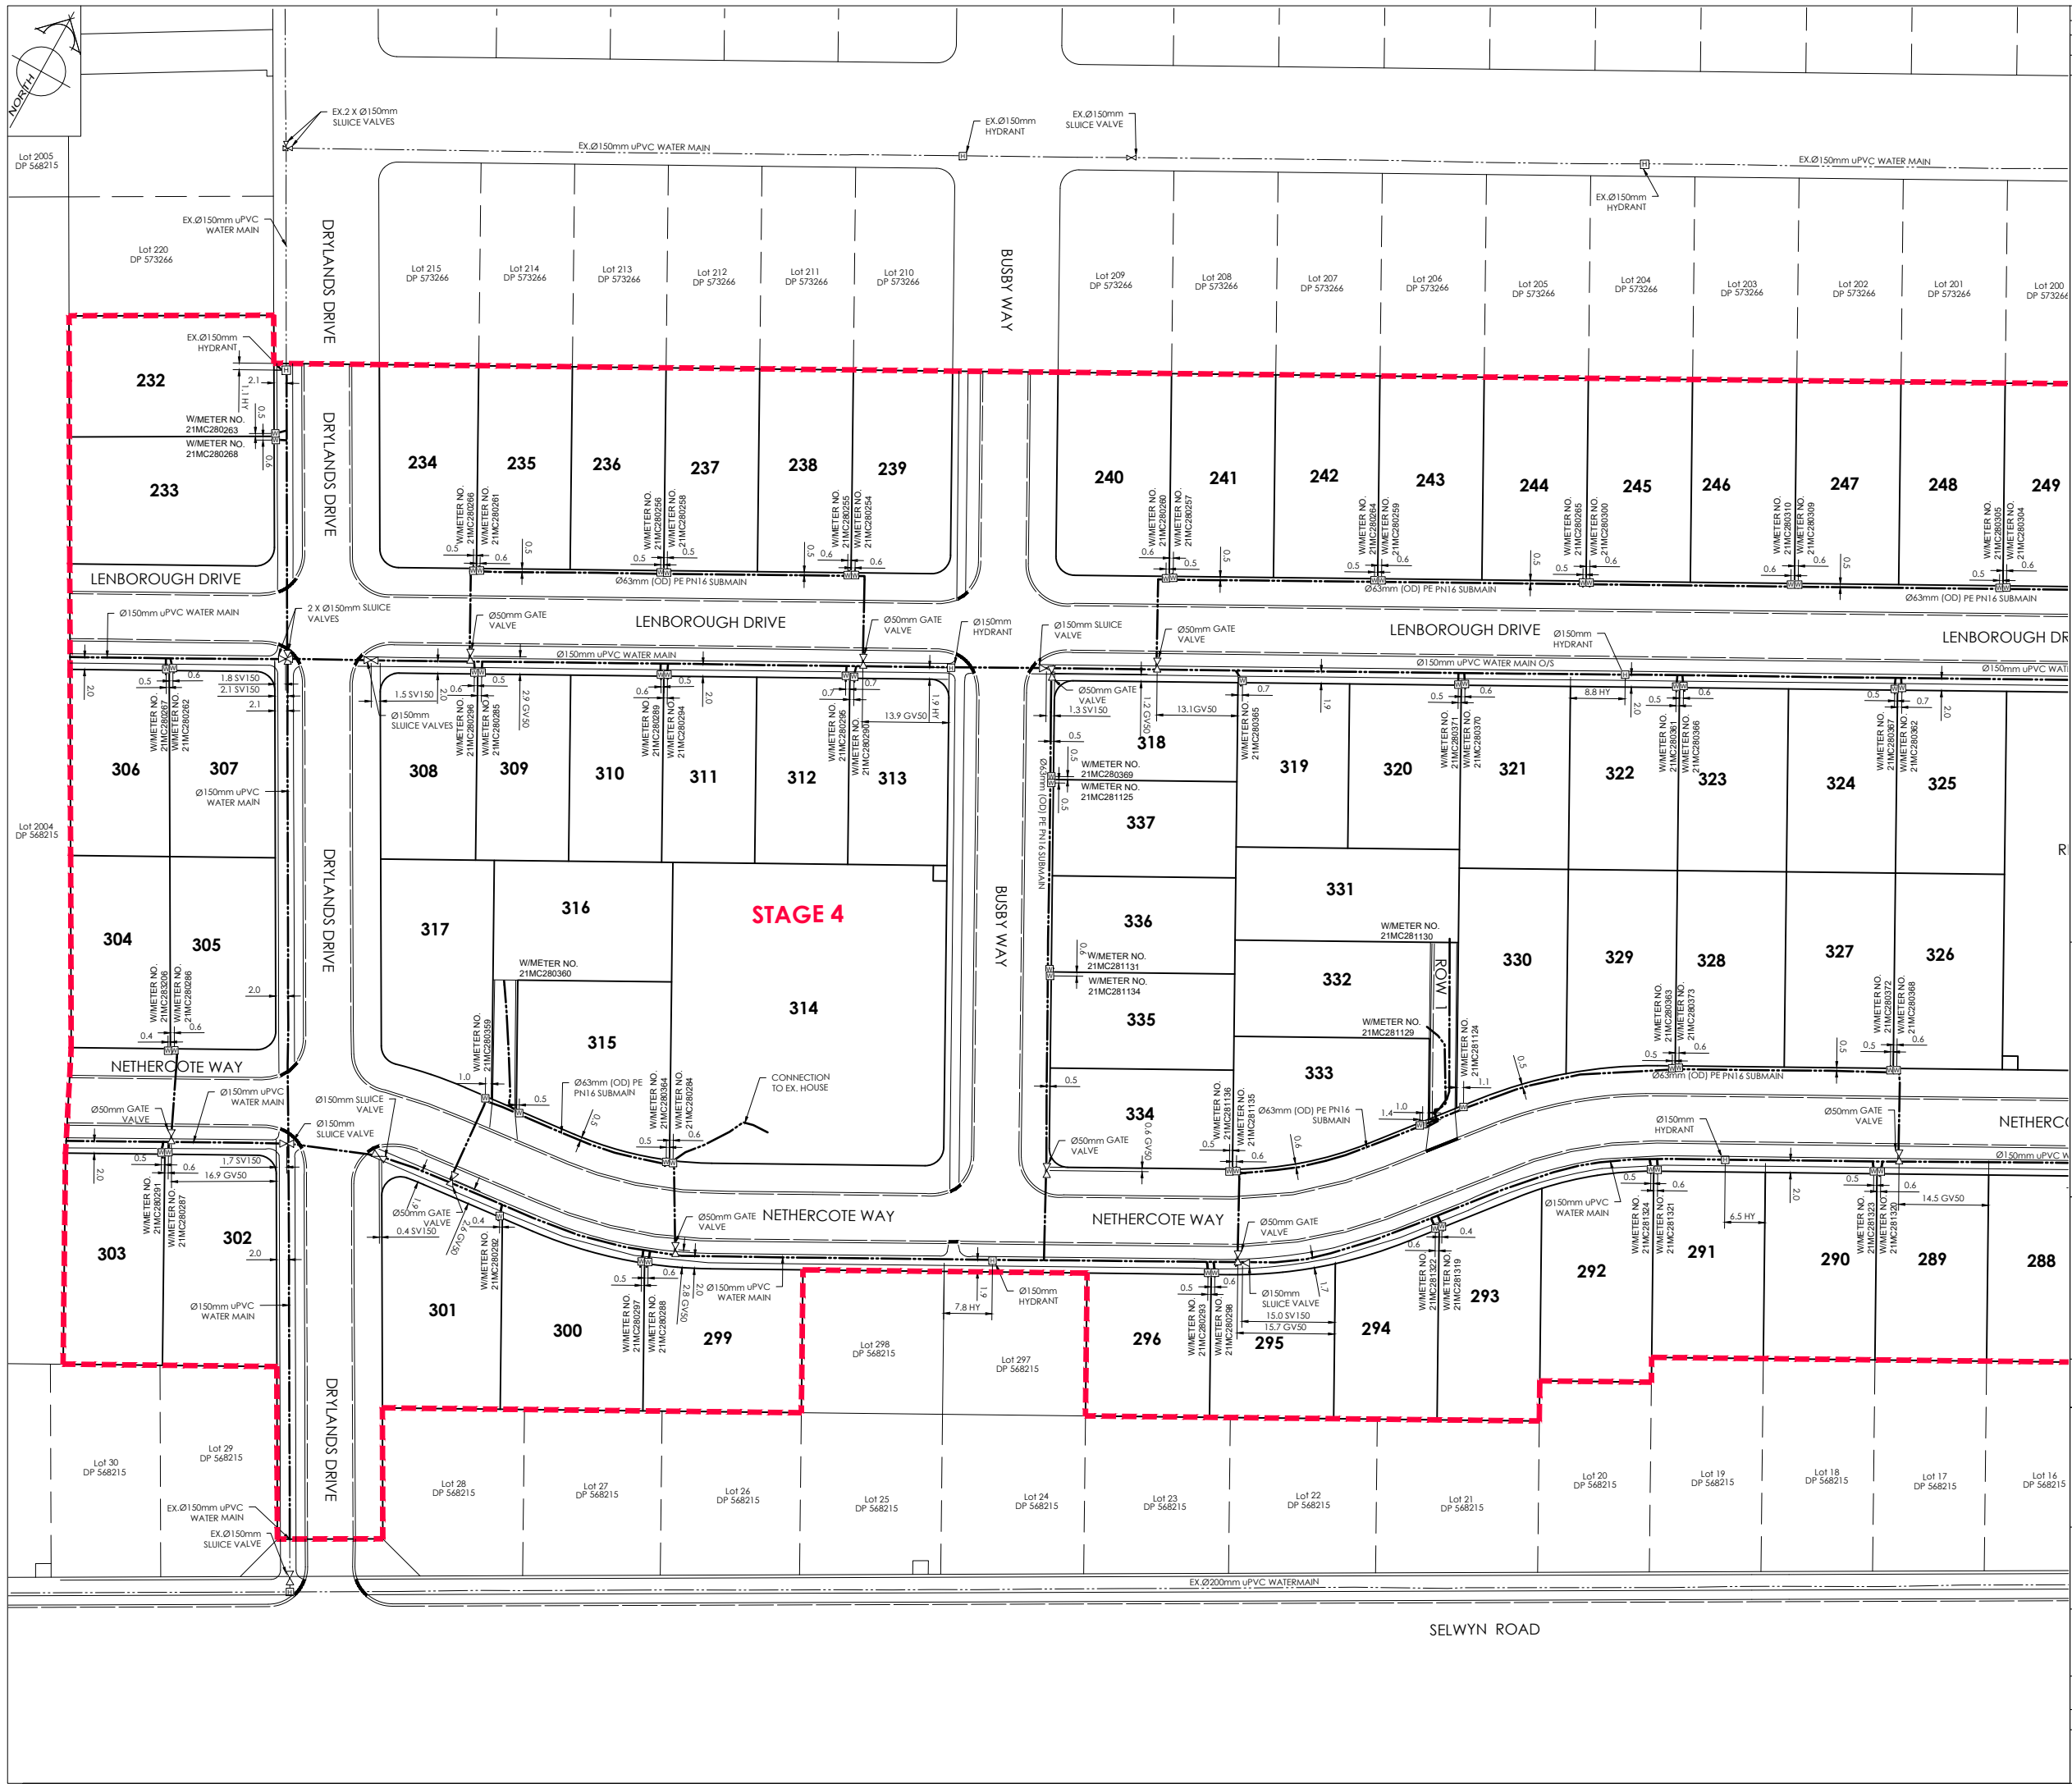

AMENDMENTS:		
AMENDMENT	DATE	DESCRIPTION

- NOTES:
1. This plan has been prepared for water asbuilt purposes only. No liability is accepted if the plan is used for any other purpose.
 2. Any measurements taken from information which is not dimensioned on the electronic copy are at the risk of the recipient.
 3. The asbuilt locations of all water mains, fire hydrants and valves have been provided by BG Contracting Ltd. No liability is accepted in relation to their accuracy or their location.
 4. All house connections are 25mm poly and include gate valve, Toby box, tapping band and flange.
 5. All water laterals are Ø25mm PE BlueLine PN1.5 with associated fittings unless otherwise specified.
 6. All roading and footpath information is asbuilt.

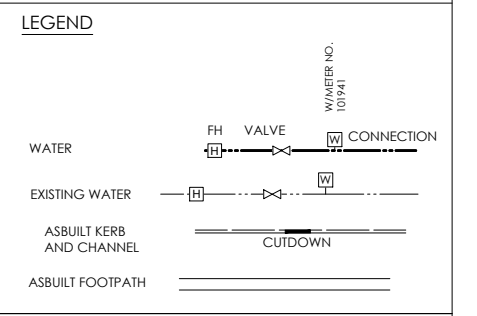

DAVIE LOVELL-SMITH
PLANNING SURVEYING ENGINEERING

116 Wrights Road P O Box 679 Christchurch 8140. New Zealand
Telephone: 03 379-0793 Website: www.dls.co.nz E-mail: office@dls.co.nz

JOB TITLE:

**South West Faringdon
Stage 4
RC 215485 & RC 215965**

SHEET TITLE:

Water Asbuilt

DRAWING STATUS:

Asbuilt

SCALE: 1:500@A1
1:1000@A3

DATE: July 2022

CAD FILE: J:\2025\ASBUILT\STAGE 4\H20256_STG 4 AB_NZTM_R0.dwg

DRAWING No: H.20534.AB.WS01


SHEET No: RO

REVISION: RO



AMENDMENTS:		
AMENDMENT	DATE	DESCRIPTION

- NOTES:
1. This plan has been prepared for water asbuilt purposes only. No liability is accepted if the plan is used for any other purpose.
 2. Any measurements taken from information which is not dimensioned on the electronic copy are at the risk of the recipient.
 3. The asbuilt locations of all water mains, fire hydrants and valves have been provided by BG Contracting Ltd. No liability is accepted in relation to their accuracy or their location.
 4. All house connections are 25mm poly and include gate valve, toby box, tapping band and ferule.
 5. All water laterals are Ø25mm PE BlueLine PN12.5 with associated fittings unless otherwise specified.
 6. All roading and footpath information is asbuilt.

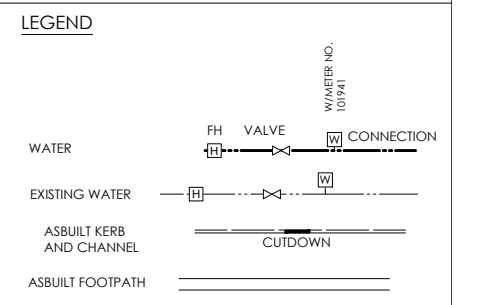


DAVIE LOVELL-SMITH
 PLANNING SURVEYING ENGINEERING

116 Wrights Road P O Box 679 Christchurch 8140. New Zealand
 Telephone: 03 379-0793 Website: www.dls.co.nz E-mail: office@dls.co.nz


JOB TITLE:
**South West Faringdon
 Stage 4
 RC 215485 & RC 215965**

SHEET TITLE:
Water Asbuilt

DRAWING STATUS:
Asbuilt


SCALE: 1:500@A1 DATE: July 2022
 1:1000@A3

CAD FILE: J:\2025\ASBUILT\STAGE 4\H20256_STG 4 AB_NZTM_R0.dwg DRAWN: CR
 DRAWING No: SHEET No: REVISION:
H.20534.AB.WS02 RO

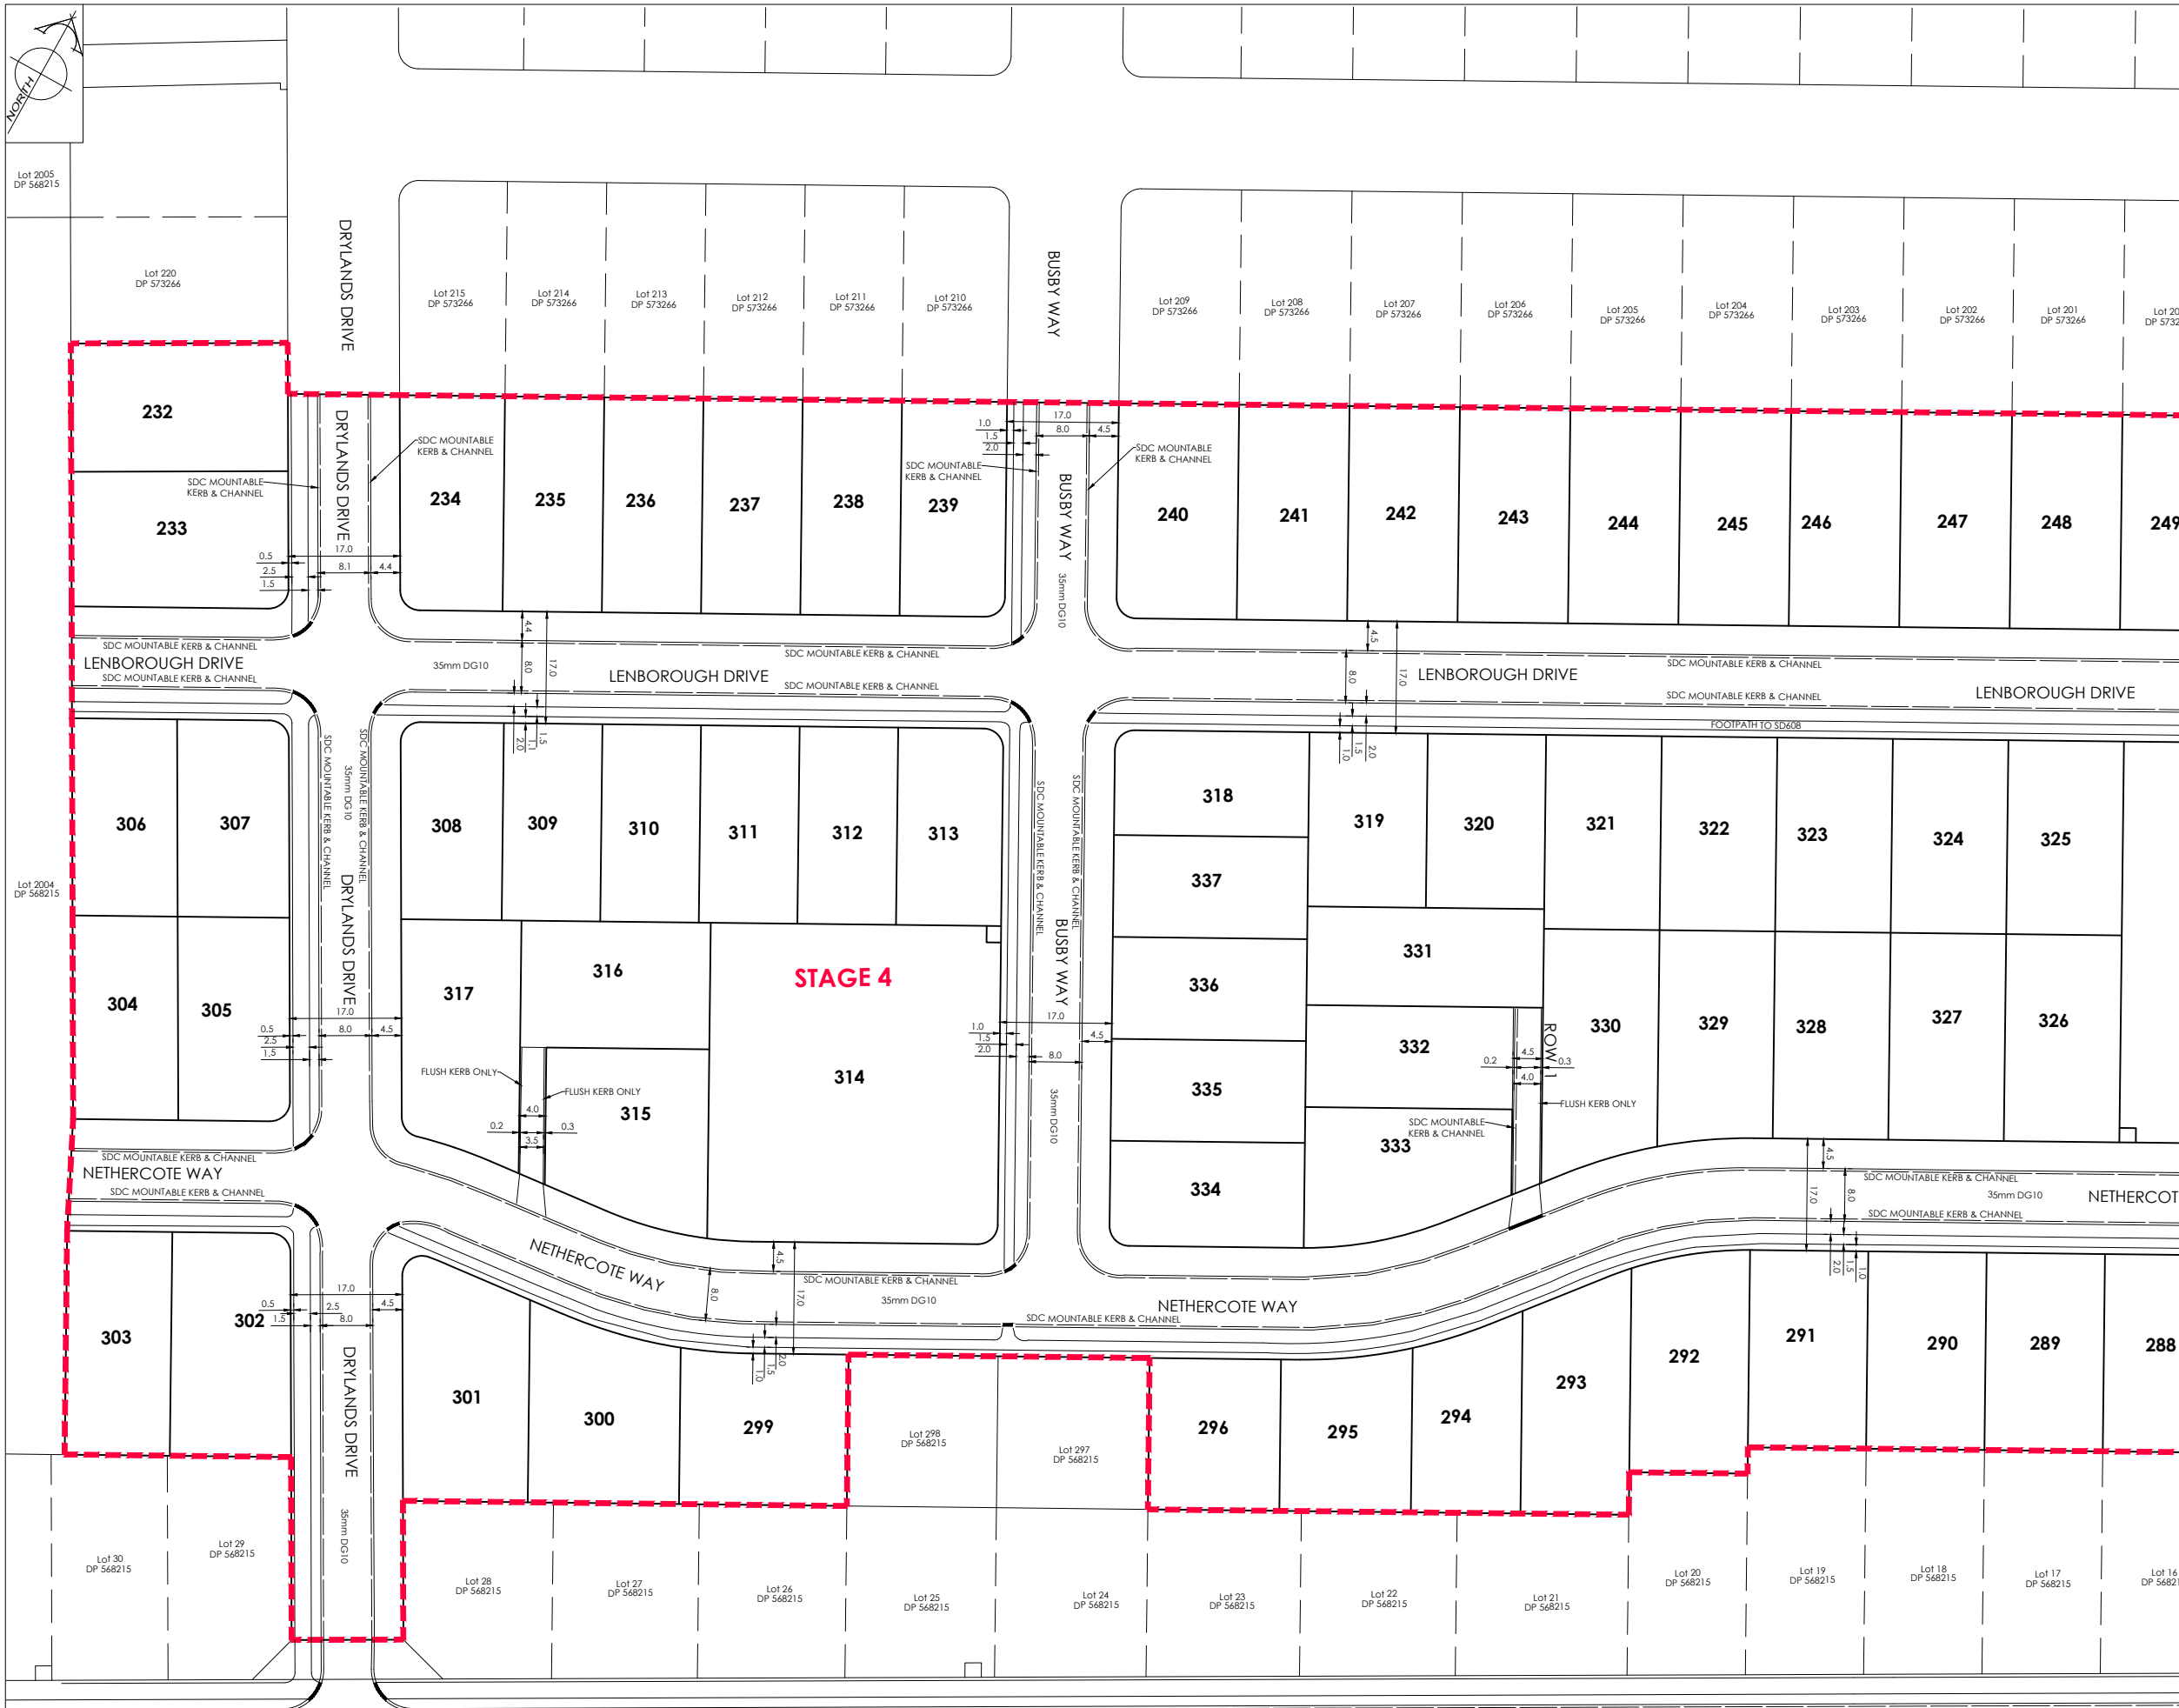

AMENDMENTS:		
AMENDMENT	DATE	DESCRIPTION

- NOTES:
1. This plan has been prepared for road asbuilt purposes only. No liability is accepted if the plan is used for any other purpose.
 2. Any measurements taken from information which is not dimensioned on the electronic copy are at the risk of the recipient.
 3. Carriageway dimensions shown are from face of kerb to face of kerb.

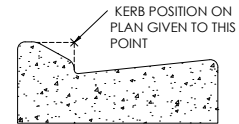

MOUNTABLE KERB & CHANNEL

LEGEND	
ASBUILT KERB AND CHANNEL	CUTDOWN
ASBUILT FOOTPATH	

DAVIE LOVELL-SMITH
 PLANNING SURVEYING ENGINEERING

116 Wrights Road P O Box 679 Christchurch 8140. New Zealand
 Telephone: 03 379-0793 Website: www.dls.co.nz E-mail: office@dls.co.nz

JOB TITLE:
South West Faringdon Stage 4
RC 215485 & RC 215965

SHEET TITLE:
Road Asbuilt

DRAWING STATUS:
Asbuilt


SCALE: 1:500@A1 DATE: July 2022
 1:1000@A3

CAD FILE: J:\2025\ASBUILT\STAGE 4\H20256_STG 4 AB_NZTM_R0.dwg DRAWN: CR
 DRAWING No: SHEET No: REVISION:
H.20534.AB.RD01 RO



AMENDMENTS:		
AMENDMENT	DATE	DESCRIPTION

- NOTES:
1. This plan has been prepared for road asbuilt purposes only. No liability is accepted if the plan is used for any other purpose.
 2. Any measurements taken from information which is not dimensioned on the electronic copy are at the risk of the recipient.
 3. Carriageway dimensions shown are from face of kerb to face of kerb.

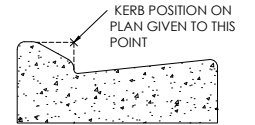

MOUNTABLE KERB & CHANNEL

LEGEND

ASBUILT KERB AND CHANNEL		CUTDOWN	
ASBUILT FOOTPATH			



116 Wrights Road P O Box 679 Christchurch 8140. New Zealand
 Telephone: 03 379-0793 Website: www.dls.co.nz E-mail: office@dls.co.nz

JOB TITLE:
**South West Faringdon
 Stage 4
 RC 215485 & RC 215965**

SHEET TITLE:
Road Asbuilt

DRAWING STATUS:
Asbuilt

SCALE: 1:500@A1 DATE: July 2022
 1:1000@A3

CAD FILE: J:\2025\ASBUILTS\STAGE 4\H20256_STG 4 AB_NZTM_RD.dwg DRAWN: CR
 DRAWING No: SHEET No: REVISION:
H.20534.AB.RD02 RO