
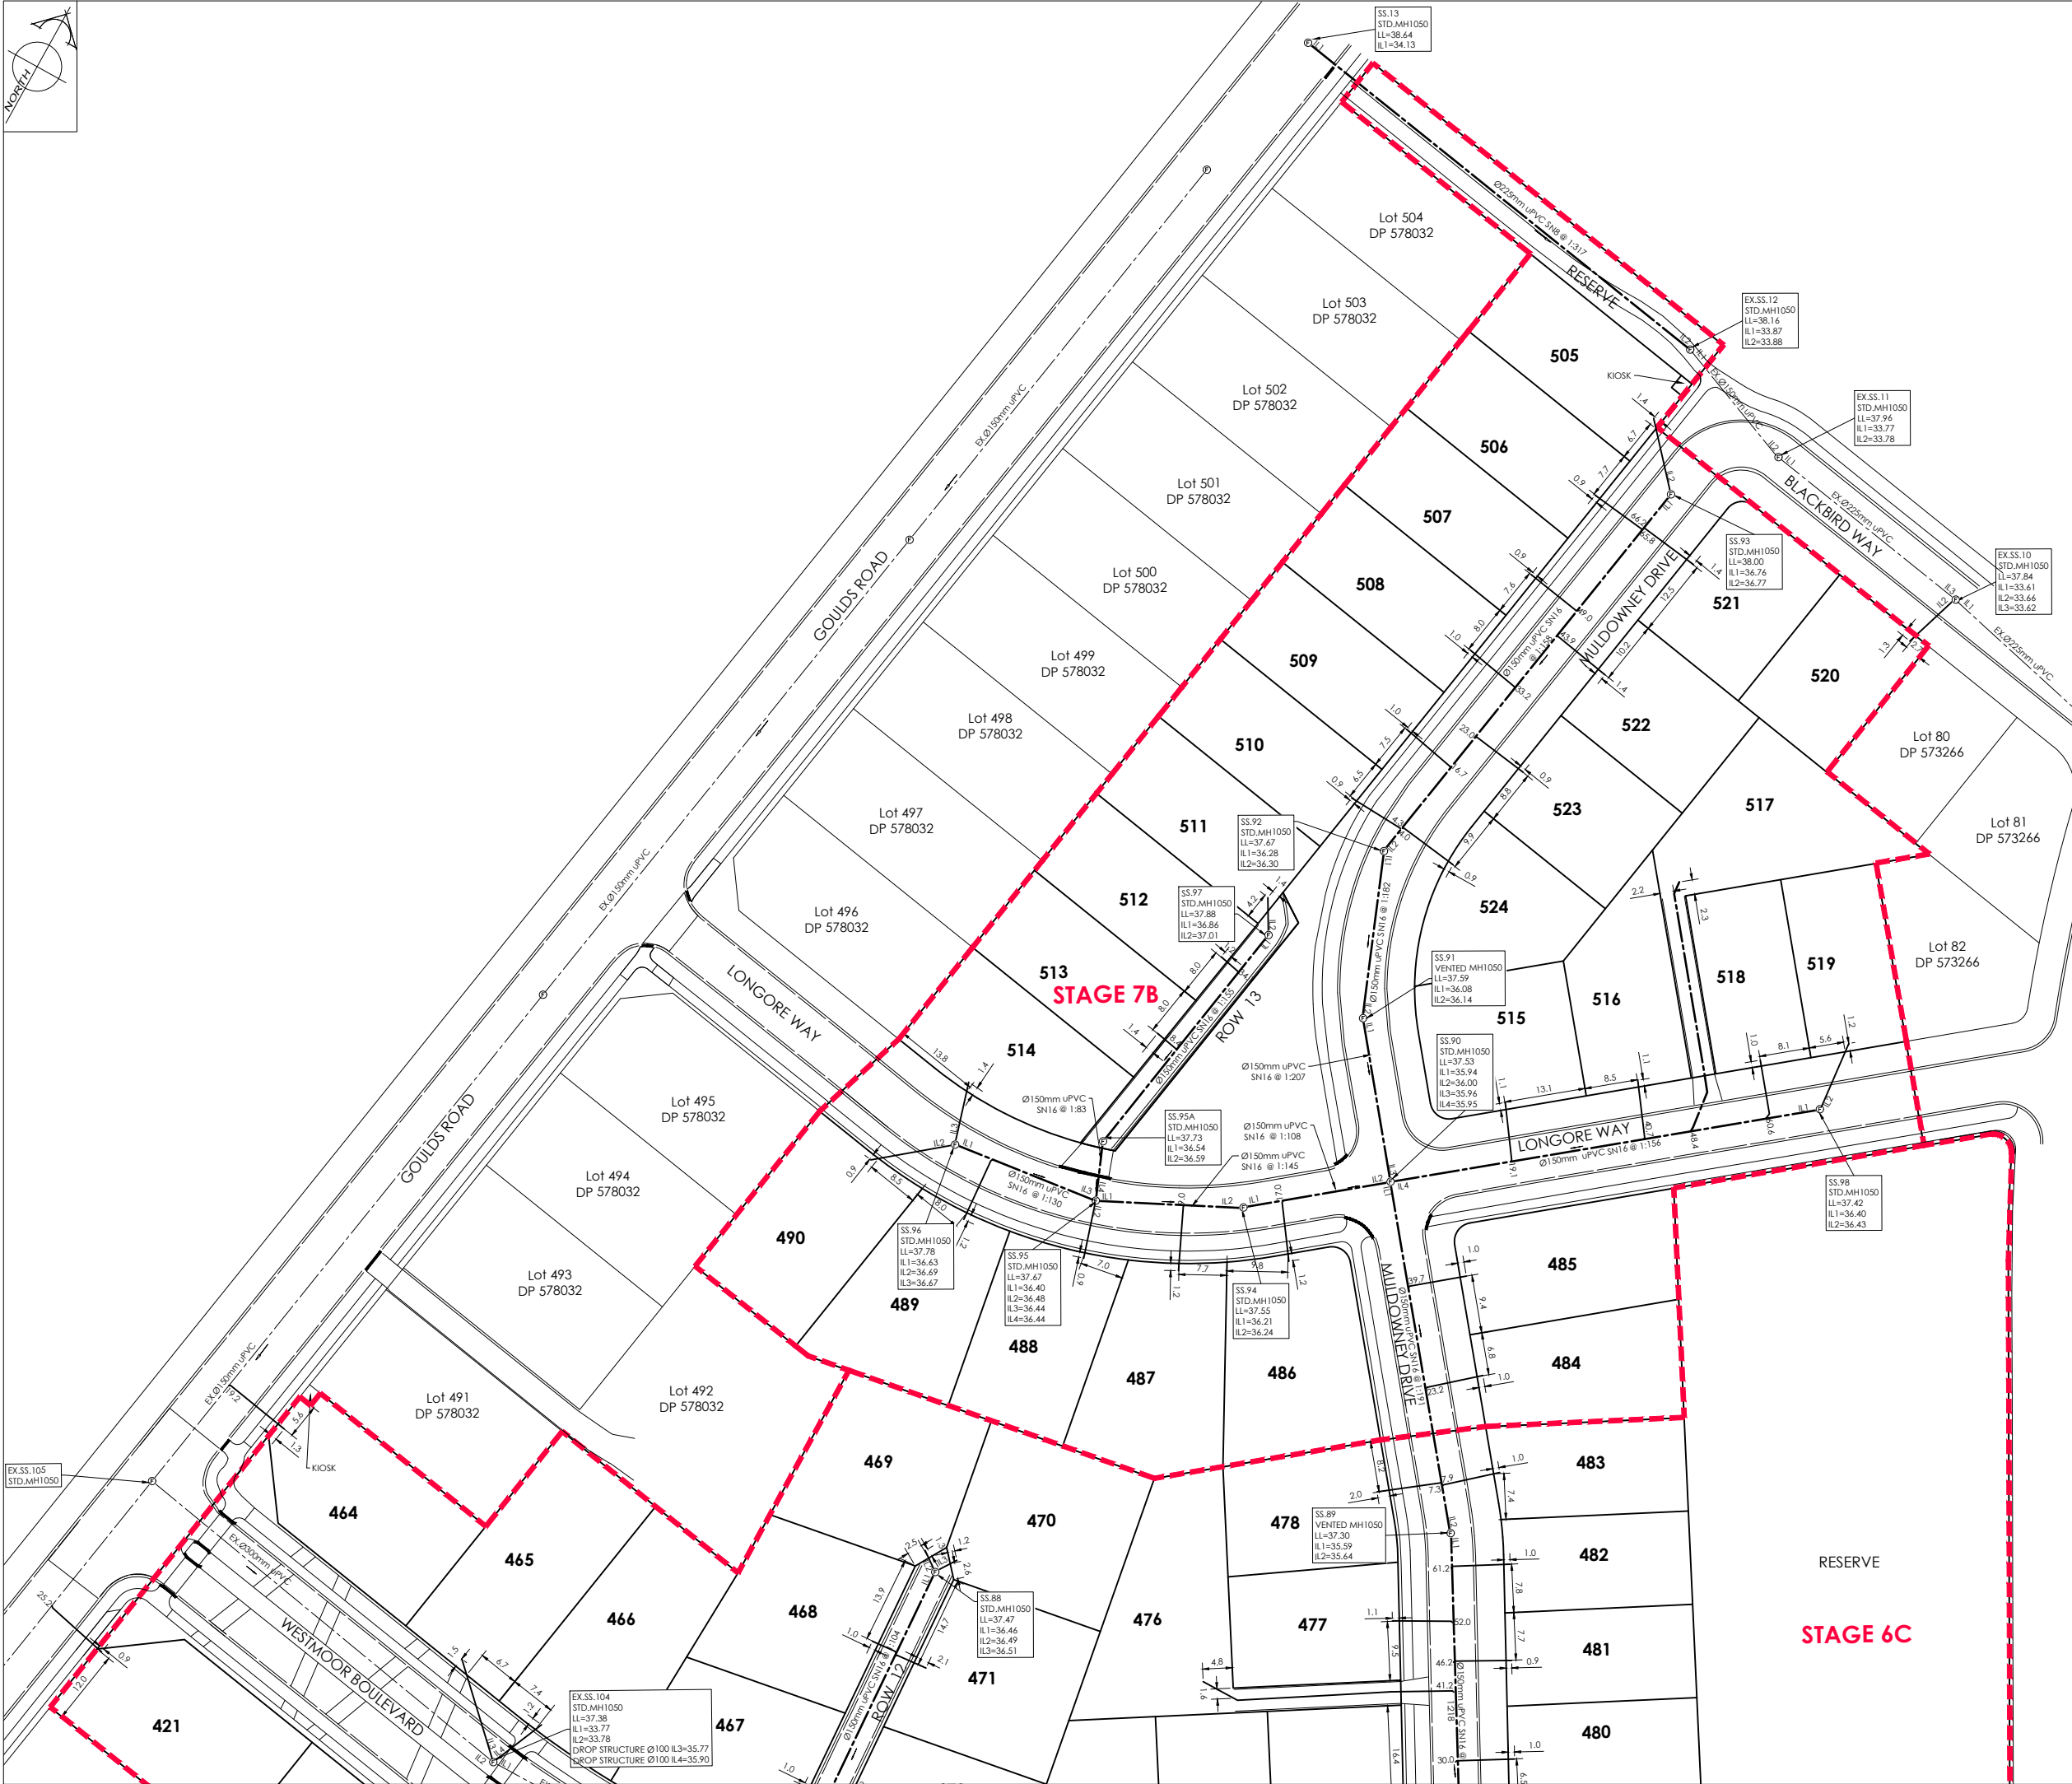


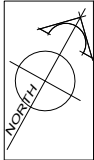

AMENDMENTS :

AMENDMENT	DATE	DESCRIPTION

NOTES :

1.

This plan has been prepared for sewer asbuilt purposes only. No liability is accepted if the plan is used for any other purpose.

2.

Any measurements taken from information which is not dimensioned on the electronic copy are at the risk of the recipient.

3.

All sewer laterals are 100mmØ uPVC SN16 unless otherwise specified.

4.

All asbuilt information on this sheet has been provided by BG Contracting Ltd and has not been verified. No liability is accepted in relation to their locations.

5.

All roading and footpath information is asbuilt.

6.

Origin of Levels:
Levels are in terms of Mean Sea Level (Lyttelton Vertical Datum 1937) prior to Canterbury earthquakes of 2010 and 2011.

LEGEND

LL=

LID LEVEL

IL=

INVERT LEVEL

SANITARY SEWER

MH

SEWER LATERAL

EXISTING SANITARY SEWER

EX.MH

EX.SEWER LATERAL

ASBUILT KERB AND CHANNEL

CUTDOWN

ASBUILT FOOTPATH

DAVIE LOVELL-SMITH

PLANNING SURVEYING ENGINEERING

116 Wrights Road

P O Box 679 Christchurch 8140, New Zealand

Telephone: 03 379-0793 Website: www.dls.co.nz E-mail: office@dls.co.nz

JOB TITLE:

South West Faringdon
Stage 6C & 7B
RC 215485 & 215965

SHEET TITLE:

Sewer Asbuilt

DRAWING STATUS

Asbuilt

SCALE: 1:500@A1
1:1000@A3

DATE: October 2022

CAD FILE: J:\20694\ASBUILT\20694_STG 6C/7B AB_NZTM R0.dwg



DRAWN : JS

DRAWING No : SHEET No:

REVISION :

H.20694.AB.SS01

R0

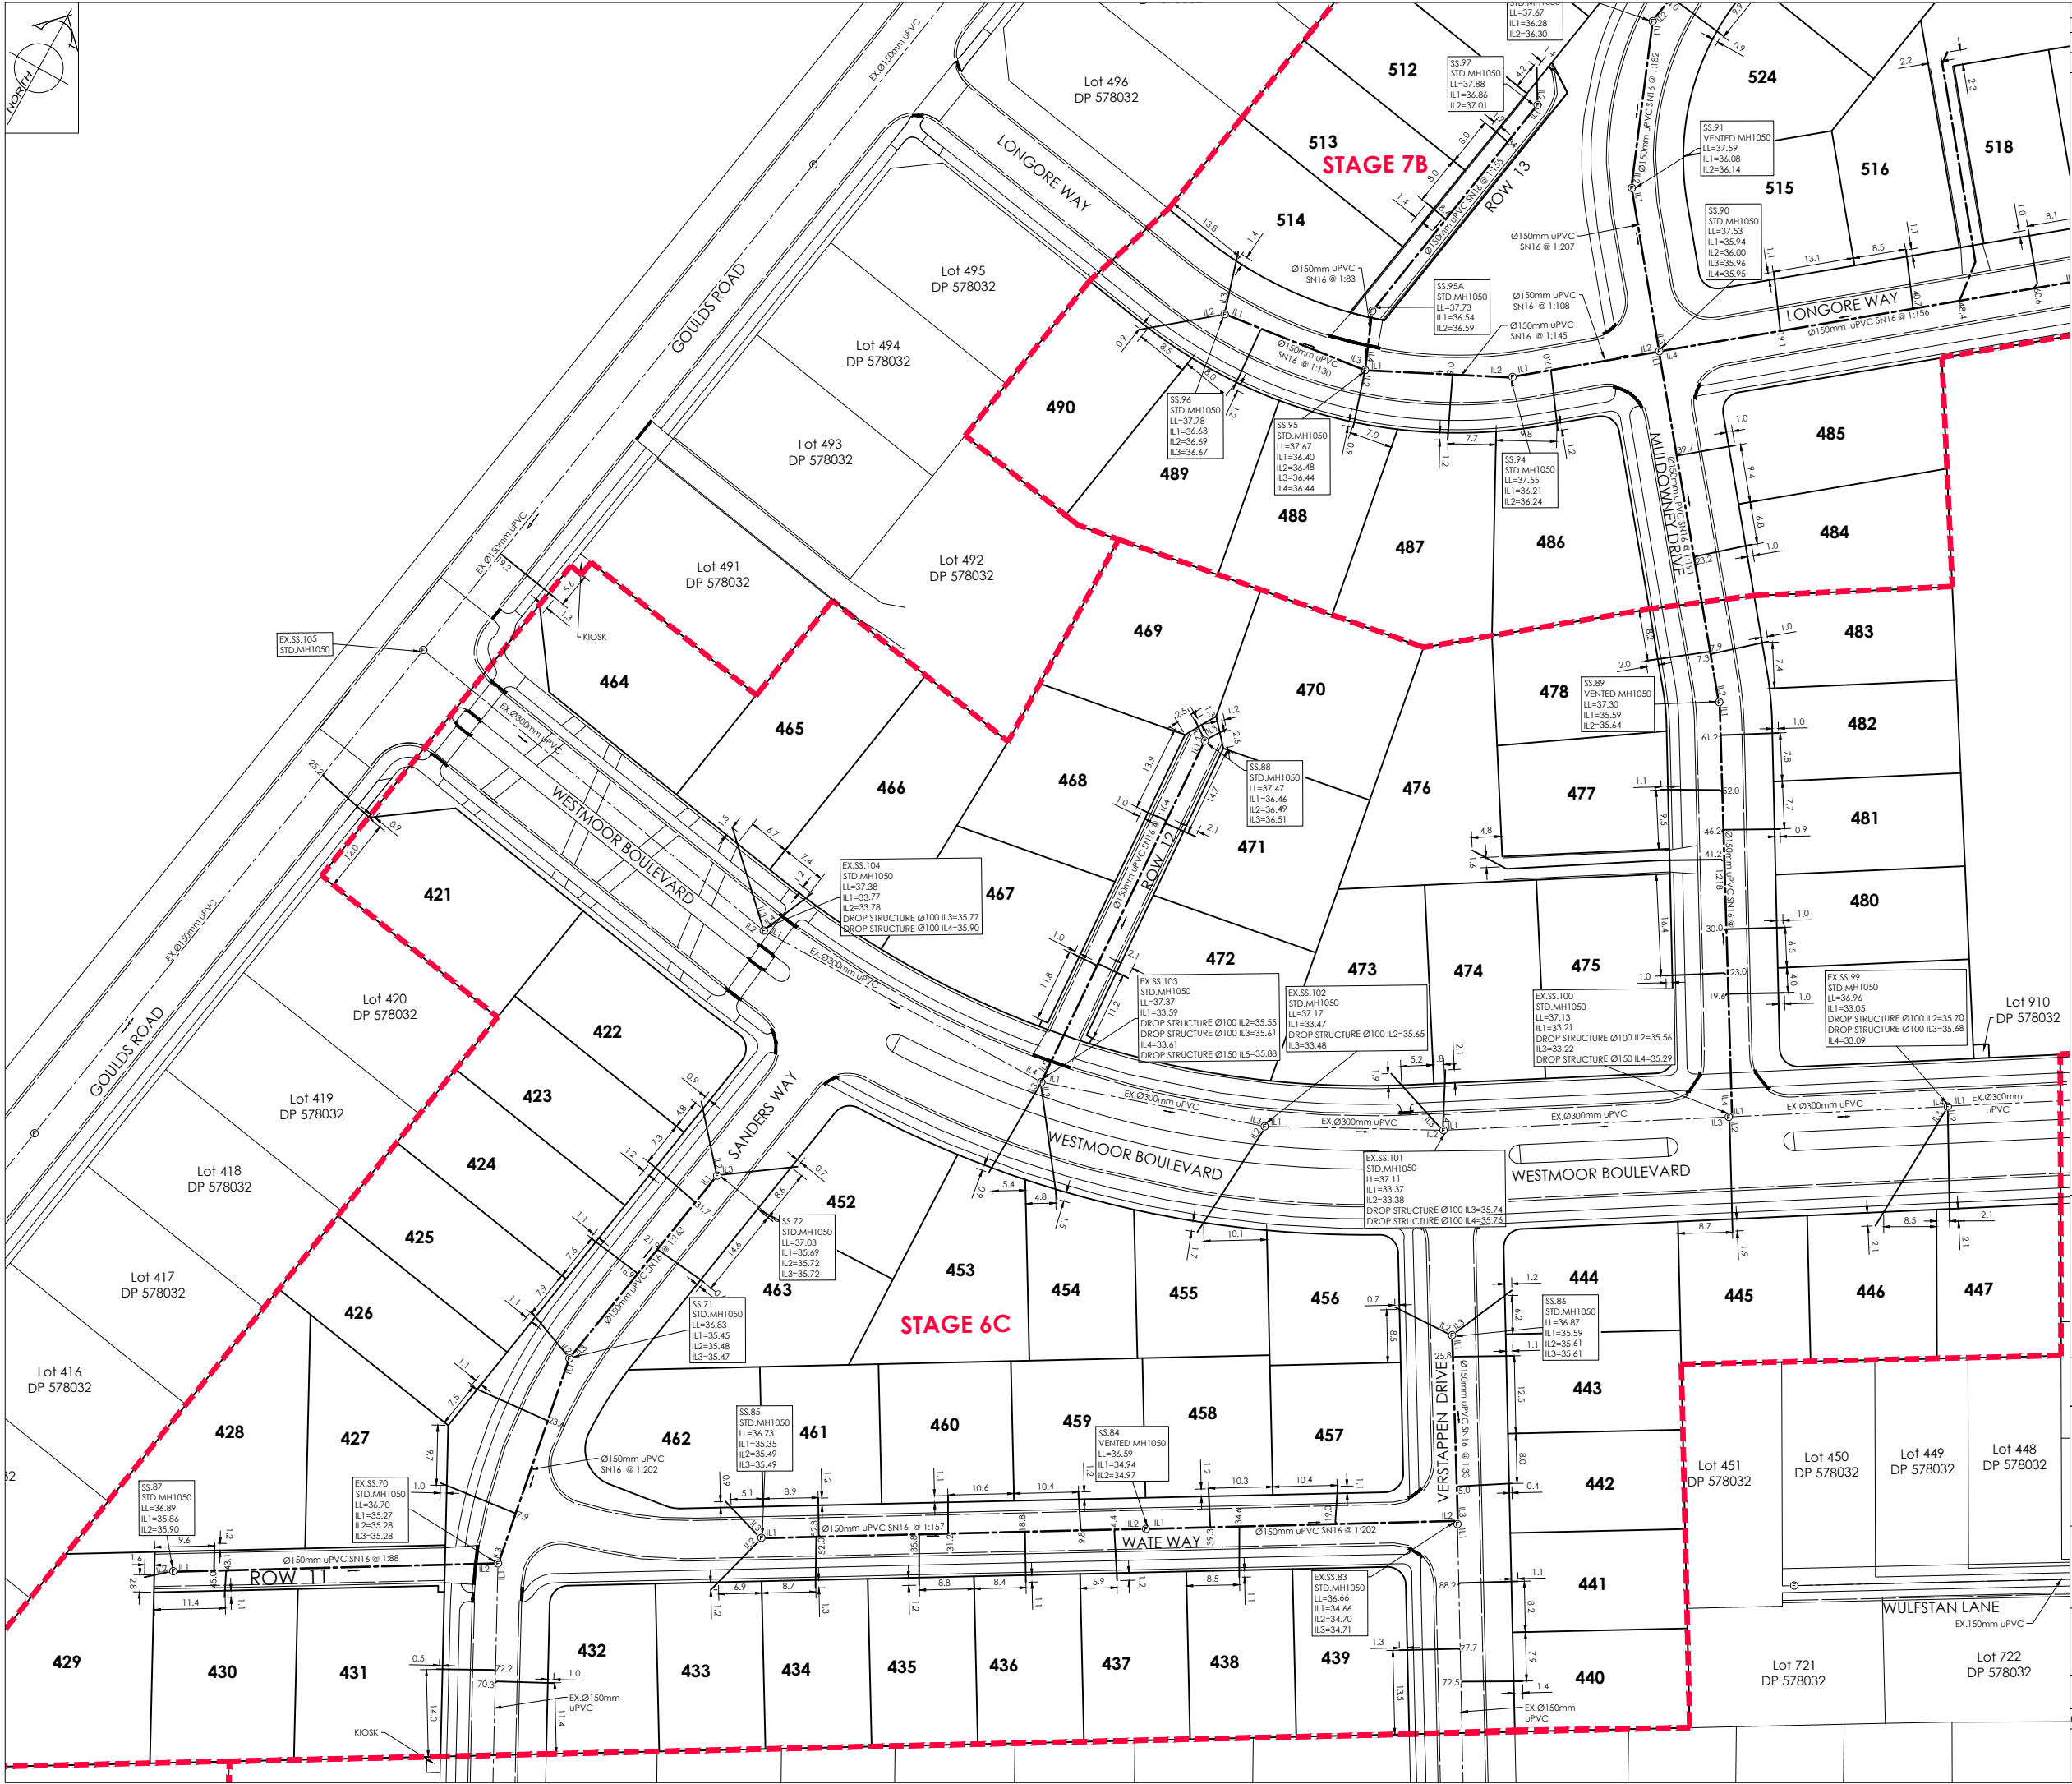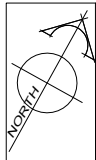

AMENDMENTS:		
AMENDMENT	DATE	DESCRIPTION

- NOTES:
1. This plan has been prepared for sewer asbuilt purposes only. No liability is accepted if the plan is used for any other purpose.
 2. Any measurements taken from information which is not dimensioned on the electronic copy are at the risk of the recipient.
 3. All sewer laterals are 100mmØ uPVC SN16 unless otherwise specified.
 4. All asbuilt information on this sheet has been provided by BG Contracting Ltd and has not been verified. No liability is accepted in relation to their locations.
 5. All roading and footpath information is asbuilt.
 6. Origin of Levels:
Levels are in terms of Mean Sea Level (Lyttelton Vertical Datum 1937) prior to Canterbury earthquakes of 2010 and 2011.

LEGEND

LL=	LID LEVEL	
IL=	INVERT LEVEL	
SANITARY SEWER		SEWER LATERAL
EXISTING SANITARY SEWER		EX. SEWER LATERAL
ASBUILT KERB AND CHANNEL		CUTDOWN
ASBUILT FOOTPATH		



116 Wrights Road P O Box 679 Christchurch 8140. New Zealand
Telephone: 03 379-0793 Website: www.dls.co.nz E-mail: office@dls.co.nz


JOB TITLE:
**South West Faringdon
Stage 6C & 7B
RC 215485 & 215965**

SHEET TITLE:
Sewer Asbuilt

DRAWING STATUS
Asbuilt

SCALE: 1:500@A1
1:1000@A3
DATE: October 2022

CAD FILE: J:\2019\Asbuilt\20694_STG 6C&7B_AB_NZTM.R0.dwg
DRAWING No: H.20694.AB.SS02
SHEET No: RO
DRAWN: JS
REVISION:

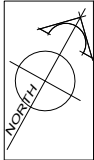

AMENDMENTS:		
AMENDMENT	DATE	DESCRIPTION

- NOTES:
1. This plan has been prepared for stormwater asbuilt purposes only. No liability is accepted if the plan is used for any other purpose.
 2. Any measurements taken from information which is not dimensioned on the electronic copy are at the risk of the recipient.
 3. All asbuilt information on this sheet has been provided by BG Contracting Ltd and have not been verified. No liability is accepted in relation to their locations.
 4. All roading and footpath information is asbuilt.
 5. Origin of Levels:
Levels are in terms of Mean Sea Level (Lyttelton Vertical Datum 1937) prior to Canterbury earthquakes of 2010 and 2011.

LEGEND	
TKS=	TOP OF KERB AT SUMP
TL=	TIP LEVEL
STORMWATER	
EXISTING STORMWATER	EX.MH
ASBUILT KERB AND CHANNEL	SUMP DOUBLE SUMP CUTDOWN
ASBUILT FOOTPATH	



DAVIE LOVELL-SMITH
PLANNING SURVEYING ENGINEERING

116 Wrights Road P O Box 679 Christchurch 8140. New Zealand
Telephone: 03 379-0793 Website: www.dls.co.nz E-mail: office@dls.co.nz

JOB TITLE:

**South West Faringdon
Stage 6C & 7B
RC 215485 & 215965**

SHEET TITLE:

Stormwater Asbuilt

DRAWING STATUS

Asbuilt

SCALE: 1:500@A1
1:1000@A3

DATE: October 2022


CAD FILE: J:\2019\ASBUILT\20694_STG 6C/7B AB_NZTM R0.dwg

DRAWN: JS

DRAWING No: **H.20694.AB.SW01**

SHEET No: **RO**

REVISION:

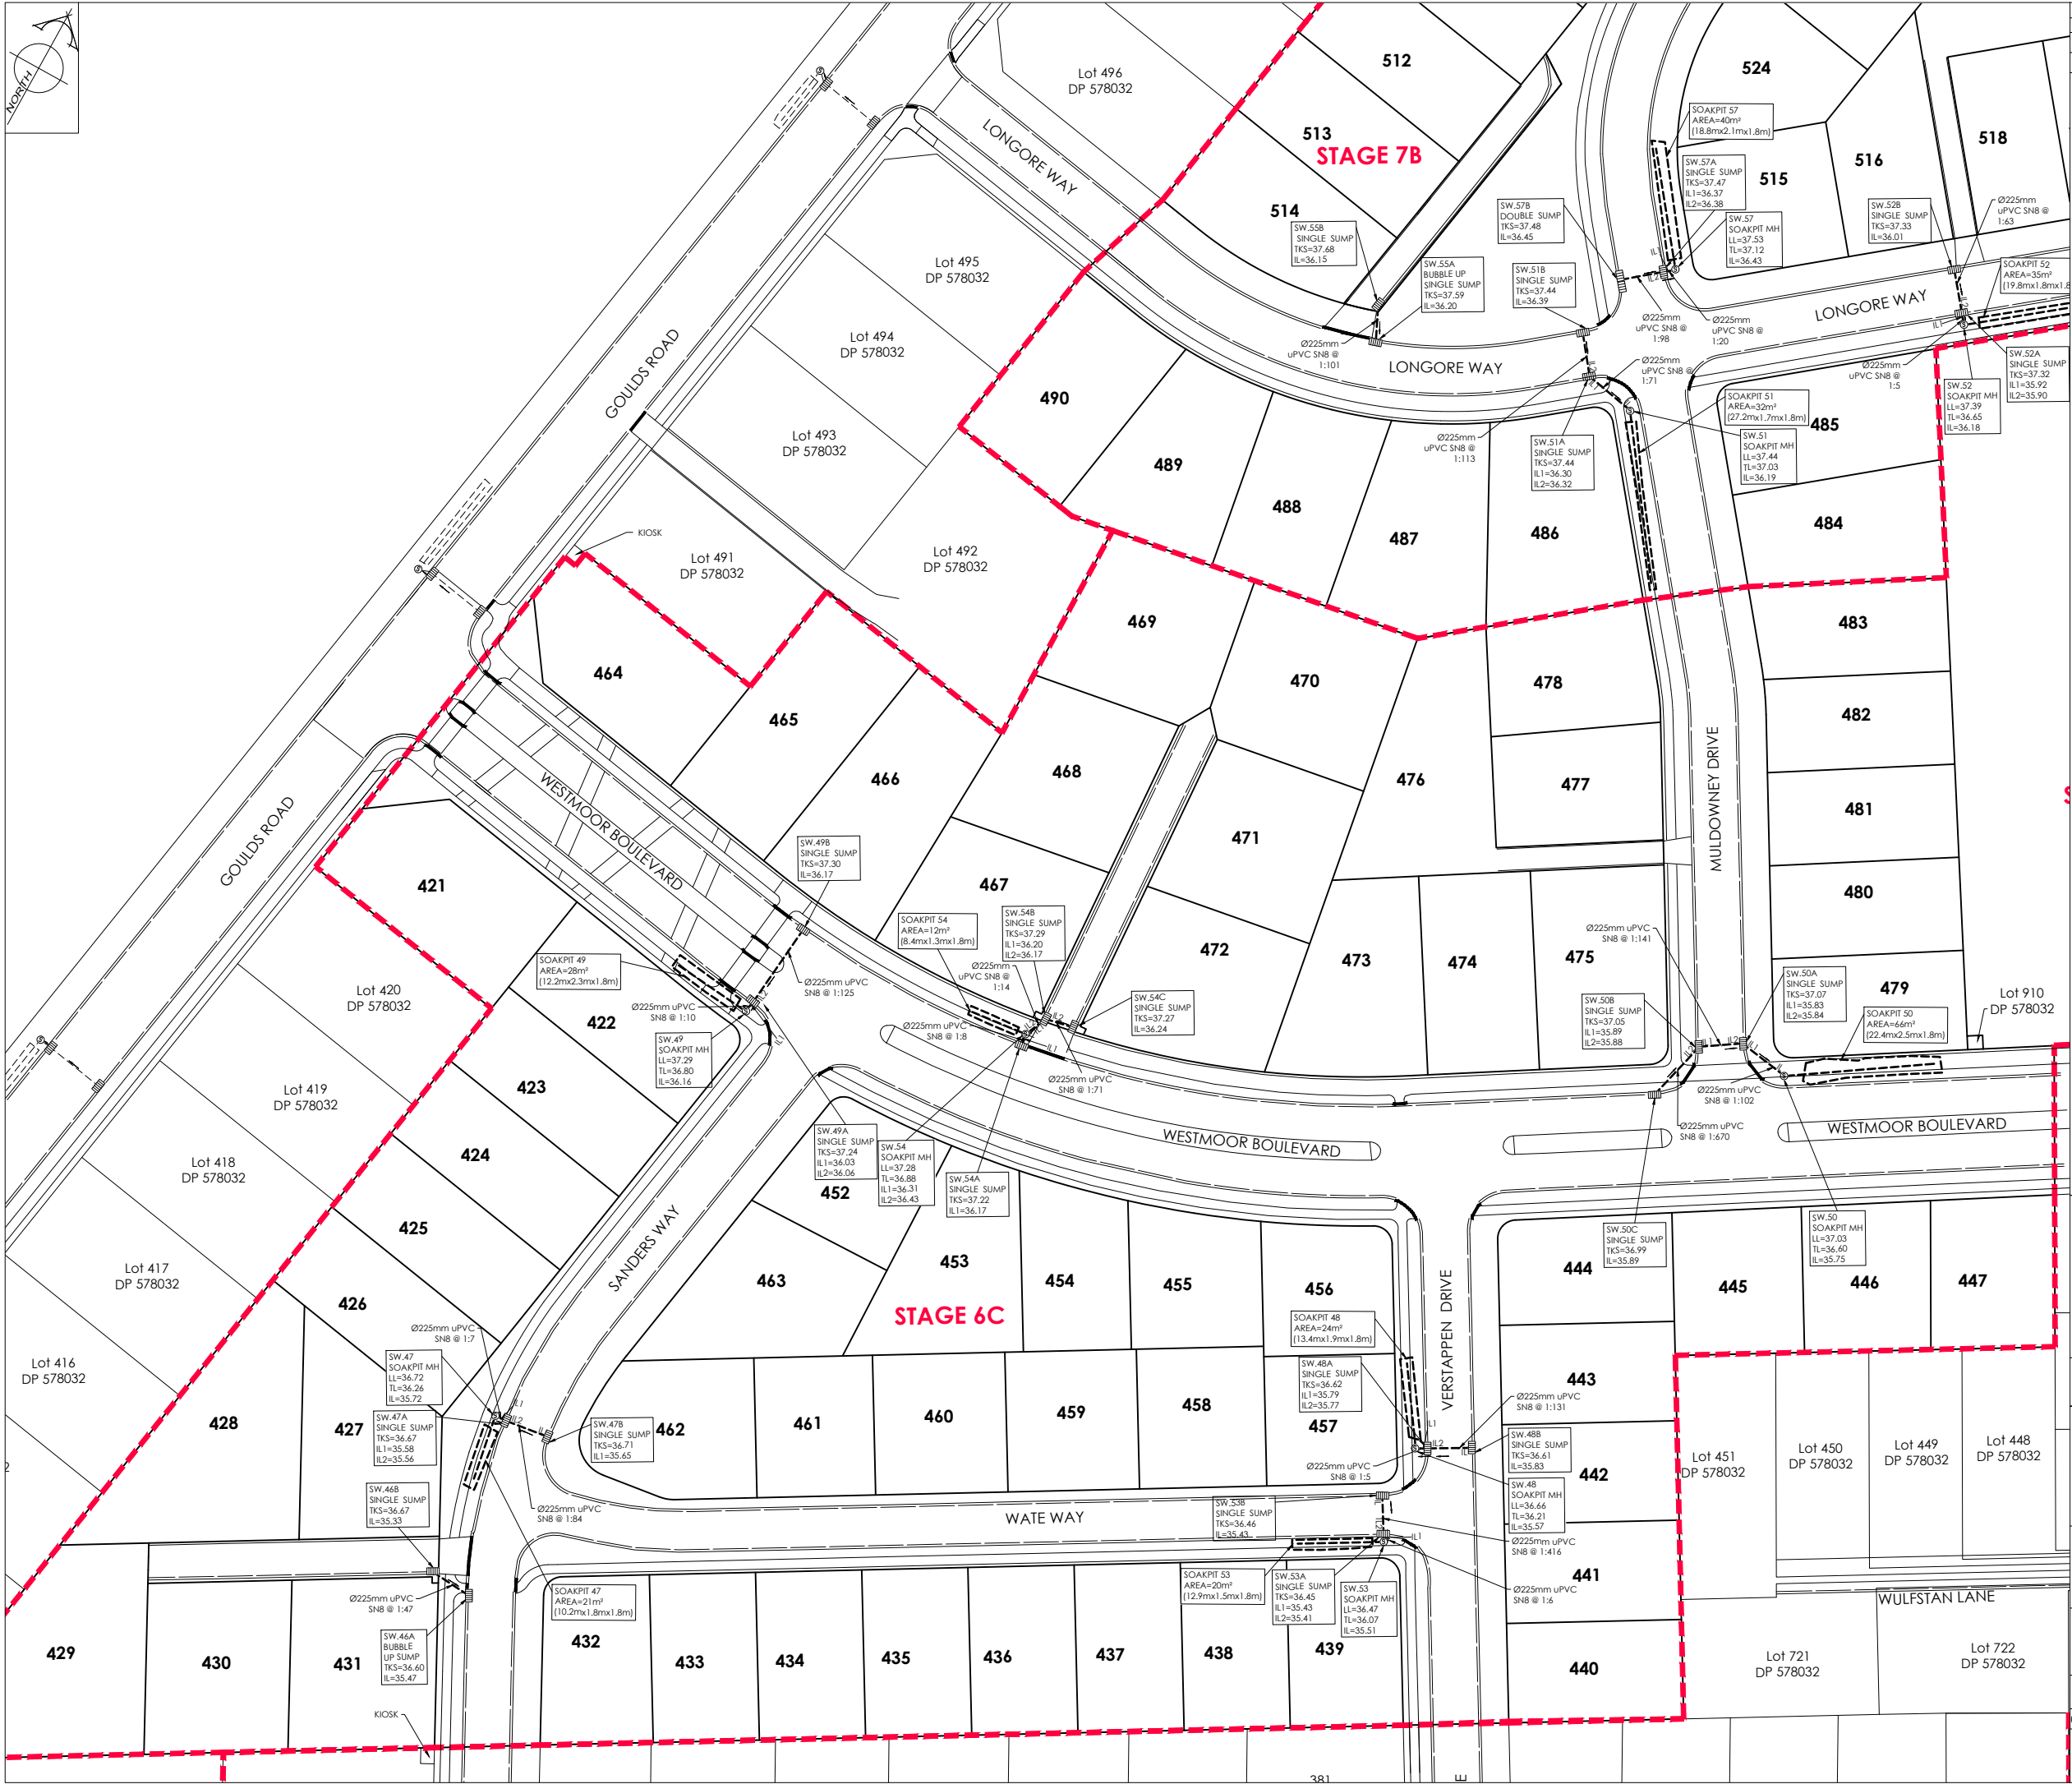

NOTES :

1. This plan has been prepared for stormwater asbuilt purposes only. No liability is accepted if the plan is used for any other purpose.
2. Any measurements taken from information which is not dimensioned on the electronic copy are at the risk of the recipient.
3. All asbuilt information on this sheet has been provided by BG Contracting Ltd and have not been verified. No liability is accepted in relation to their locations.
4. All roading and footpath information is asbuilt.
5. Origin of Levels:
Levels are in terms of Mean Sea Level (Lyttelton Vertical Datum 1937) prior to Canterbury earthquakes of 2010 and 2011.

LEGEND

TKS= TOP OF KERB AT SUMP
TL= TIP LEVEL

STORMWATER

EXISTING STORMWATER

ASBUILT KERB AND CHANNEL

ASBUILT FOOTPATH

MH

EX.MH

SUMP

DOUBLE SUMP

CUTDOWN

The diagram illustrates a cross-section of a stormwater drainage system. It features a dashed line representing the existing ground surface, which has a slight dip towards a manhole (MH) and an existing manhole (EX.MH). Below this, a solid line represents the as-built ground surface, which is higher and flatter, with two rectangular structures labeled 'SUMP' and 'DOUBLE SUMP'. A 'CUTDOWN' is indicated between the two sumps. The diagram also shows the 'ASBUILT KERB AND CHANNEL' and 'ASBUILT FOOTPATH' at the bottom. The legend defines 'TKS' as 'TOP OF KERB AT SUMP' and 'TL' as 'TIP LEVEL'.





SHEET TITLE:

Stormwater Asbuilt

SCALE: 1:500@A1
1:1000@A3

CAD FILE : J:\20694\Asbuilt\H20694_STG 6C&7B_AB_NZTM R0.dwg		DRAWN : JS
DRAWING No :	SHEET No:	REVISION :
H.20694.AB.SW02		R0

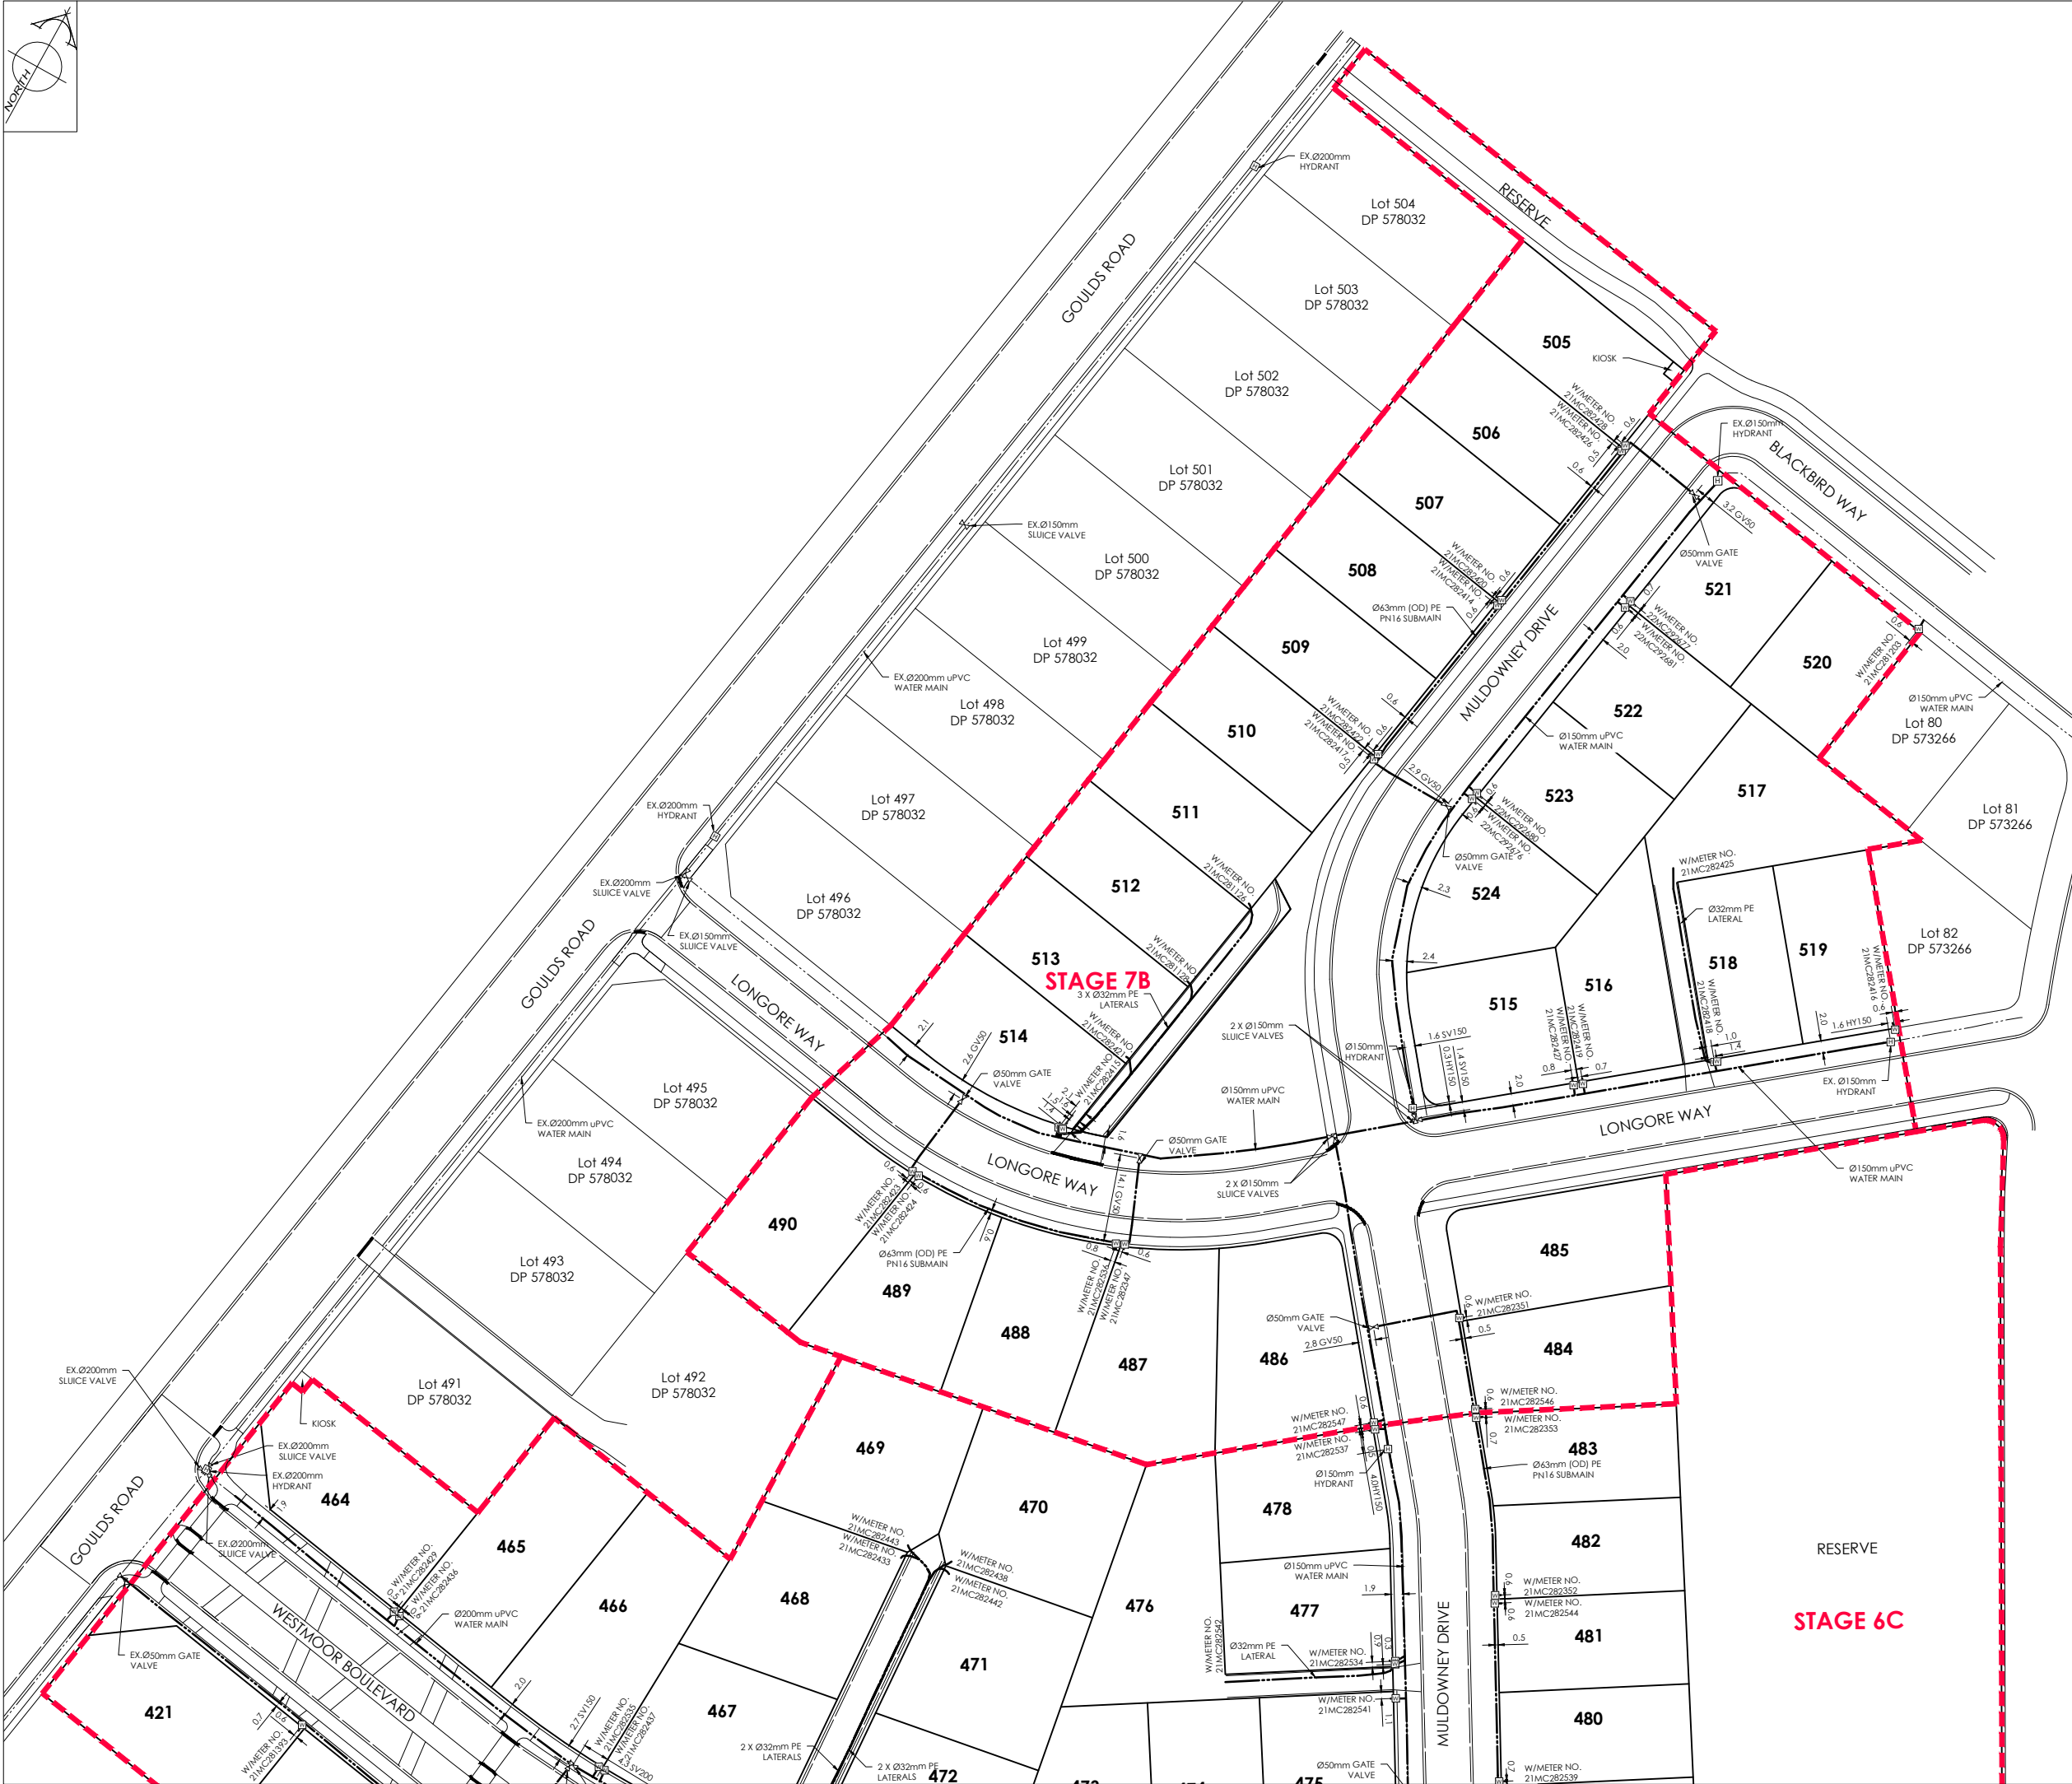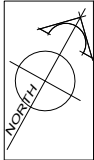

AMENDMENTS :		
AMENDMENT	DATE	DESCRIPTION

- NOTES :
1. This plan has been prepared for water asbuilt purposes only. No liability is accepted if the plan is used for any other purpose.
 2. Any measurements taken from information which is not dimensioned on the electronic copy are at the risk of the recipient.
 3. The asbuilt locations of all watermains & submains, fire hydrants and valves on this sheet have been provided by BG Contracting Ltd. No liability is accepted in relation to their accuracy or their location.
 4. All house connections are 25mm poly and include gate valve , toby box, tapping band and ferrule.
 5. All water laterals are Ø25mm PE BlueLine PN12.5 with associated fittings unless otherwise specified.
 6. All roading and footpath information is asbuilt.

LEGEND

WATER

FH VALVE CONNECTION

EXISTING WATER

ASBUILT KERB AND CHANNEL

CUTDOWN

ASBUILT FOOTPATH

DAVIE LOVELL-SMITH
PLANNING SURVEYING ENGINEERING

116 Wrights Road P O Box 679 Christchurch 8140. New Zealand
Telephone: 03 379-0793 Website: www.dls.co.nz E-mail: office@dls.co.nz

JOB TITLE:

**South West Faringdon
Stage 6C & 7B
RC 215485 & 215965**

SHEET TITLE:

Water Asbuilt

DRAWING STATUS

Asbuilt

SCALE: 1:500@A1
1:1000@A3


DATE: October 2022

CAD FILE : J:\20694\Asbuilt\20694_STG 6C/7B_AB_NZTM R0.dwg

DRAWN : JS

DRAWING No : SHEET No :
H.20694.AB.WS01

REVISION :
R0

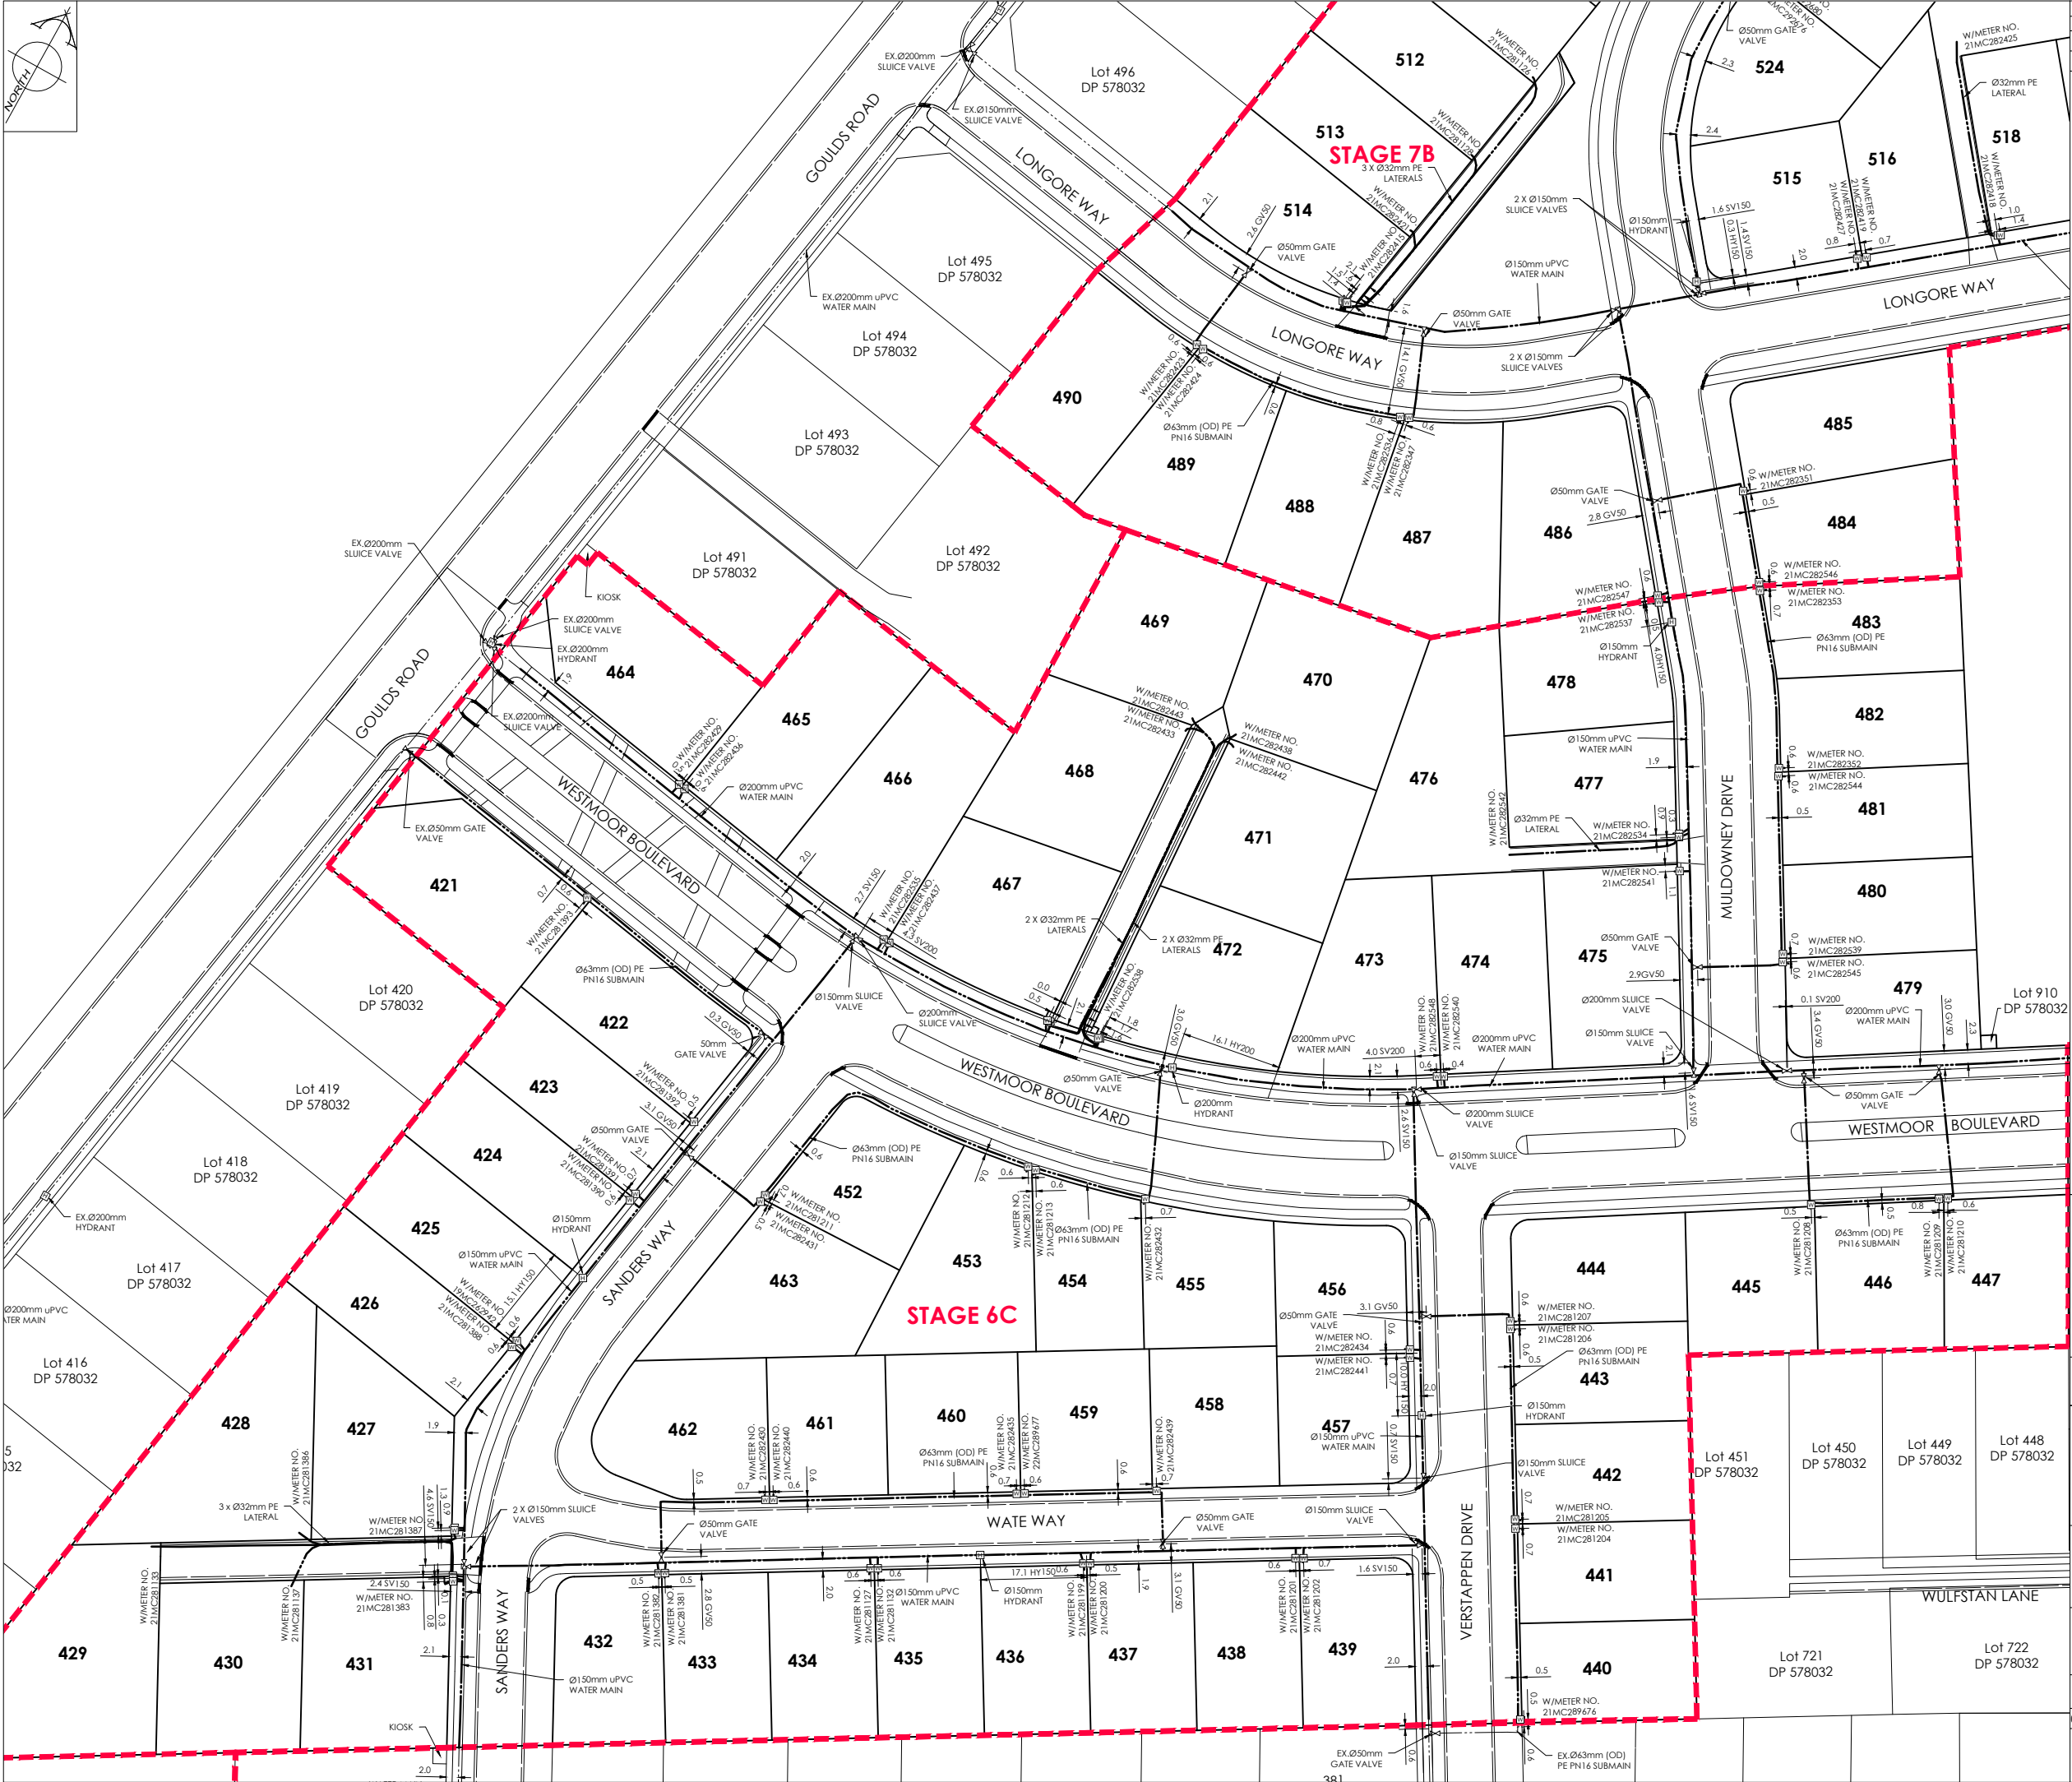

AMENDMENTS :

AMENDMENT	DATE	DESCRIPTION

NOTES :

1. This plan has been prepared for water asbuilt purposes only. No liability is accepted if the plan is used for any other purpose.
2. Any measurements taken from information which is not dimensioned on the electronic copy are at the risk of the recipient.
3. The asbuilt locations of all watermains & submains, fire hydrants and valves on this sheet have been provided by BG Contracting Ltd. No liability is accepted in relation to their accuracy or their location.
4. All house connections are 25mm poly and include gate valve , toby box, tapping band and ferrule.
5. All water laterals are Ø25mm PE BlueLine PN12.5 with associated fittings unless otherwise specified.
6. All roading and footpath information is asbuilt.

LEGEND

WATER

EXISTING WATER

ASBUILT KERB AND CHANNEL

ASBUILT FOOTPATH

FH

VALVE

W

CONNECTION

CUTDOWN

DAVE LOVELL-SMITH

PLANNING SURVEYING ENGINEERING

116 Wrights Road

P O Box 679 Christchurch 8140, New Zealand

Telephone: 03 379-0793 Website: www.dls.co.nz E-mail: office@dls.co.nz

JOB TITLE:

South West Faringdon
Stage 6C & 7B
RC 215485 & 215965

SHEET TITLE:

Water Asbuilt

DRAWING STATUS

Asbuilt

SCALE: 1:500@A1
1:1000@A3


DATE: October 2022

CAD FILE : J:\20694\Asbuilt\20694_STG 6C&7B_AB_NZTM R0.dwg

DRAWING No : SHEET No:


H.20694.AB.WS02

DRAWN : JS
REVISION :
R0

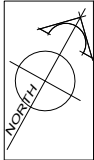

AMENDMENTS:		
AMENDMENT	DATE	DESCRIPTION

- NOTES:
1. This plan has been prepared for road asbuilt purposes only. No liability is accepted if the plan is used for any other purpose.
 2. Any measurements taken from information which is not dimensioned on the electronic copy are at the risk of the recipient.
 3. Carriageway dimensions shown are from face of kerb to face of kerb.
 4. All roading information is asbuilt.

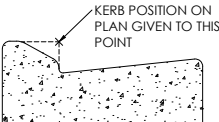

MOUNTABLE KERB & CHANNEL

LEGEND	
COBBLES	
EXPOSED AGGREGATE	
ASBUILT KERB AND CHANNEL	
ASBUILT FOOTPATH	
CUTDOWN	



116 Wrights Road P O Box 679 Christchurch 8140. New Zealand
Telephone: 03 379-0793 Website: www.dls.co.nz E-mail: office@dls.co.nz


JOB TITLE:
**South West Faringdon
Stage 6C & 7B
RC 215485 & 215965**

SHEET TITLE:
Roading Asbuilt

DRAWING STATUS
Asbuilt


SCALE: 1:500@A1
1:1000@A3
DATE: October 2022

CAD FILE: J:\20694\Asbuilt\20694_STG 6C&7B_AB_NZTM RD.dwg	DRAWN: JS
DRAWING No: H.20694.AB.RD01	REVISION: R0

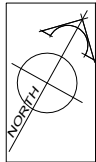

AMENDMENTS :		
AMENDMENT	DATE	DESCRIPTION

- NOTES :
1. This plan has been prepared for road asbuilt purposes only. No liability is accepted if the plan is used for any other purpose.
 2. Any measurements taken from information which is not dimensioned on the electronic copy are at the risk of the recipient.
 3. Carriageway dimensions shown are from face of kerb to face of kerb.
 4. All roading information is asbuilt.

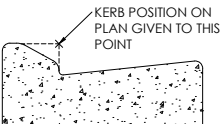

MOUNTABLE KERB & CHANNEL

LEGEND	
COBBLES	
EXPOSED AGGREGATE	
ASBUILT KERB AND CHANNEL	
ASBUILT FOOTPATH	
CUTDOWN	



116 Wrights Road P O Box 679 Christchurch 8140. New Zealand
Telephone: 03 379-0793 Website: www.dls.co.nz E-mail: office@dls.co.nz

JOB TITLE:
**South West Faringdon
Stage 6C & 7B
RC 215485 & 215965**

SHEET TITLE:
Roading Asbuilt

DRAWING STATUS
Asbuilt

SCALE : 1:500@A1
1:1000@A3
DATE : October 2022

CAD FILE : J:\20694\Asbuilt\20694-STG 6C&7B AB_NZTM R0.dwg
DRAWING No : SHEET No :
H.20694.AB.RD02
DRAWN : JS
REVISION :
R0